

Wayne
H 2007
8/8/77

MISSISSIPPI
BOARD OF WATER COMMISSIONERS
416 North State Street
13^P Jackson, Mississippi 39201

WATER WELL DRILLERS LOG

8-8-77 1977 CARRS well service WAYNE
date well completed firm name county well located

LANDOWNER: HR-TUCKER
Rt 1 Waynesboro Miss
(mailing address)

WELL LOCATION:
sec. 8 T. 9 N. R. 7 E.
7 miles NNW of Waynesboro
(distance) (direction) (nearest town)

WELL PURPOSE: Home
(home, irrigation, municipal, industrial)

WELL COMPLETION DATA:

(1) diameter (inches) 2"

(2) total depth (feet) 67

(3) static water level (feet) 37 ^{below} above top of ground.

(4) casing PVC, 54
(material) (depth)
(size) if telescope see back.

(5) screen 5', 54
(length) (depth to top)
2", PVC 8 slot
(size) (material)

(6) pump 1, 10
(HP) (yield gpm)
Elect
(type power)

(7) electric log No
(yes or no)

(organization running log)

(8) how well bottom plugged 2" PVC
CAP

description of formations encountered	from	to
Top Soil	0	3
Red SAND & CLAY	3	10
Red SAND	10	15
Yellow Med. SAND	15	20
COARSE Yellow SAND	20	25
Pea GRAVEL	25	28
COARSE Yellow SAND	28	53
Pea GRAVEL	53	58
BROWN Rock with		
Med Yellow SD	58	63
BLUE MARL	63	67


RECEIVED
SEP 19 1977

DRILLERS REMARKS:

MISS. Bd. OF WATER COMMISSIONERS

If well telescopes please sketch and show depths.

GROUND LEVEL

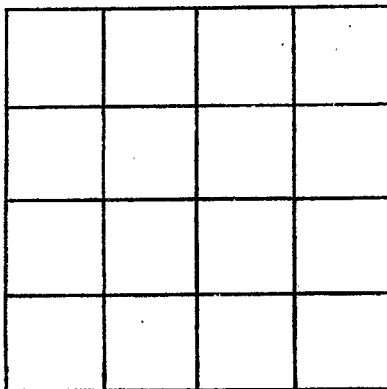

SECTION _____

Please indicate well location X.

ADDITIONAL INFORMATION

Lined area for providing additional information, consisting of approximately 20 horizontal lines.

If more than one screen, show locations of each on sketch.