

WAYNE
H 202A
11/3/77

MISSISSIPPI
BOARD OF WATER COMMISSIONERS
416 North State Street
Jackson, Mississippi 39201

WATER WELL DRILLERS LOG

McILWAIN WATER WELL SERVICE

Wayne

Nov 3 19 77 date well completed
 RT. 2 BOX 37 firm name
 WAYNESBORO, MISS. 39262 county/well located

LANDOWNER:
 Alva McCall Dace
 Waynesboro Miss.
 (mailing address)

description of formations encountered	from	to
Red Sand	0	23
Clay	23	40
Sand + Clay	40	75
Sand	75	87

WELL LOCATION:
 sec. 6 T. 9 N R. 7 E
 10 7 1/2 miles NW of Wboro
 (distance) (direction) (nearest town)

WELL PURPOSE: HOME
 (home, irrigation, municipal, industrial)

- WELL COMPLETION DATA:
- (1) diameter (inches) 2"
 - (2) total depth (feet) 87'
 - (3) static water level (feet) 52' below top of ground.
 - (4) casing PVC 82' (material) (depth)
 2" (size) if telescope see back.
 - (5) screen 5' 82' feet (length) (depth to top)
 2" PVC (size) (material)
 - (6) pump 3/4 5 (HP) (yield gpm)
 110 AC (type power)
 - (7) electric log No (yes or no)

(organization running log)

(8) how well bottom plugged

DRILLERS REMARKS:


RECEIVED

NOV 11 1977

MISS. BD. OF WATER COMM

If well telescopes please
sketch and show depths.

GROUND LEVEL

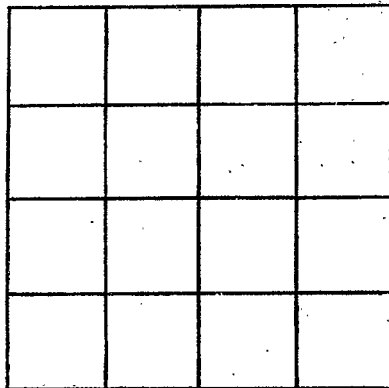

SECTION _____

Please indicate well location X.

ADDITIONAL INFORMATION

If more than one screen,
show locations of each on sketch.