

WAYNE

H 2031

9-26-78

MISSISSIPPI BOARD OF WATER COMMISSIONERS
416 North State Street
Jackson, Mississippi 39201

WATER WELL DRILLERS LOG

McILWAIN WATER WELL SERVICE

Wayne

Sept. 26 19 78
date well completed

RT 2 BOX 32
firm name WAYNESBORO, MISS. 39367

county well located


LANDOWNER:	description of formations encountered	from	to
Harold Clark Waynesboro, MS. (mailing address)			
WELL LOCATION: sec. 20 T 9 N R 7 W 10 miles NW of W'boro (distance) (direction) (nearest town)	Clay	8	20
WELL PURPOSE: HOME (home, irrigation, municipal, industrial)	SAND	20	43
WELL COMPLETION DATA: (1) diameter (inches) 2 1/2 (2) total depth (feet) 122' (3) static water level (feet) 77' below top of ground (4) casing PVC 1 1/2' (material) (depth) 2" (size) if telescope see back. (5) screen 10' 1 1/2' (length) (depth to top) 2" PVC .008 (size) (material) (6) pump 1 1/2 (HP) 6 (yield gpm) 220 AC (type power) (7) electric log NO (yes or no) (organization running log) (8) how well bottom plugged	Clay + Sand	43	89
	Clay	89	95
	COARSE SAND	95	122
DRILLERS REMARKS:			

RECEIVED
OCT 26 1978

MISS. Bd. OF WATER COMM.

If well telescopes please sketch and show depths.

GROUND LEVEL

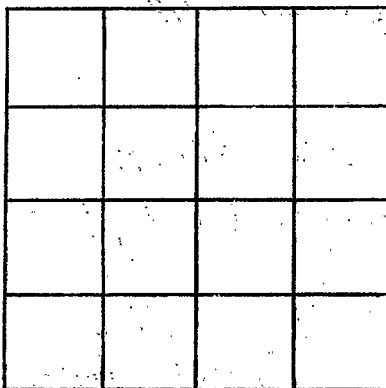

SECTION _____

Please indicate well location X.

ADDITIONAL INFORMATION

If more than one screen,
show locations of each on sketch.