

WAYNE
 H 2033
 12-15-78

MISSISSIPPI
 BOARD OF WATER COMMISSIONERS
 416 North State Street
 Jackson, Mississippi 39201

WATER WELL DRILLERS LOG
 McILWAIN WATER WELL SERVICE

Dec 15 1978 RT 2 BOX 37 WAYNE
 date well completed WAYNESBORO, MISS. 39367 county well located


LANDOWNER:	description of formations encountered	from	to
Ralph Doherty Waynesboro Miss. (mailing address)			
WELL LOCATION:	Sand & Clay	3	14
sec. 8 T. 9 N R. 7 E 7 miles NW of W. boro (distance) (direction) (nearest town)	Sand	14	16
WELL PURPOSE: Home (home, irrigation, municipal, industrial)	Gravel & Sand	16	23
WELL COMPLETION DATA:	Clay & Sand	23	27
(1) diameter (inches) 2"	Clay	27	29
(2) total depth (feet) 45'	Sand	29	30
(3) static water level (feet) 38 1/2' below top of ground.	Clay	30	31
(4) casing PVC 40' (material) (depth) 2" If telescope see back. (size)	Sand	31	34
(5) screen 5' 40' (length) (depth to top) 2" PVC .008 (size) (material)	Clay	34	35
(6) pump 1 10 (HP) (yield gpm) 220 Ac (type power)	Sand & Some Clay	35	37
(7) electric log No (yes or no)	Sand	37	45
(organization running log)			
(8) how well bottom plugged			
DRILLERS REMARKS:			

RECEIVED
 JAN 16 1978

MISS. BD. OF WATER COM.

If well telescopes please sketch and show depths.

GROUND LEVEL

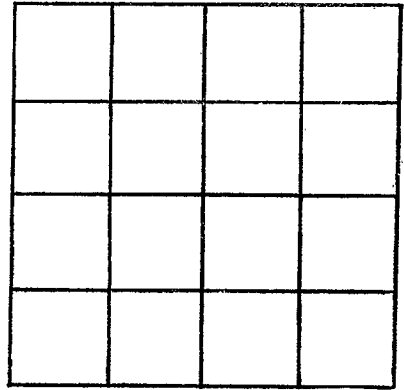

SECTION _____

Please indicate well location X.

ADDITIONAL INFORMATION

If more than one screen,
show locations of each on sketch.