

WAYNE

H 2034

11-28-78

MISSISSIPPI BOARD OF WATER COMMISSIONERS  
416 North State Street  
Jackson, Mississippi 39201

WATER WELL DRILLERS LOG

Nov. 28

date well completed

WICHITAIN WATER WELL SERVICE

firm name

Wayne

county well located

LANDOWNER:

Claude Ray Davis

Waynesboro Miss.

(mailing address)

WELL LOCATION:

sec 34 T 9 N R 7 E

2 miles NW of Wboro  
(distance) (direction) (nearest town)

WELL PURPOSE: Home  
(home, irrigation, municipal, industrial)

WELL COMPLETION DATA:

- (1) diameter (inches) 2"
- (2) total depth (feet) 100'
- (3) static water level (feet) 25' below top of ground.
- (4) casing PVC 75' (material), (depth), 2" (size) if telescope see back.
- (5) screen NONE, (length), (depth to top), (size), (material)
- (6) pump 1 (HP), 10 (yield gpm), 220 AC (type power)
- (7) electric log No (yes or no)

(organization running log)

(8) how well bottom plugged

DRILLERS REMARKS:

description of formations encountered

from

to

Sand

0

8

Sand & Clay

8

17

Rock & Clay

17

42

Brown Clay

42

71

Rock

71

75

Honey Comb

75

100


RECEIVED

JAN 16 1978

MISS. Bd. OF WATER COMM.

If well telescopes please sketch and show depths.

GROUND LEVEL

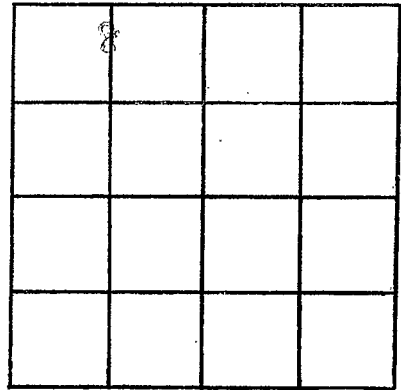

SECTION \_\_\_\_\_

Please indicate well location X.

ADDITIONAL INFORMATION

If more than one screen, show locations of each on sketch.