

WAYNE
 H 2035
 4-29-78

MISSISSIPPI
 BOARD OF WATER COMMISSIONERS
 416 North State Street
 Jackson, Mississippi 39201
 WATER WELL DRILLERS LOG

April 29 1978 date well completed
 McILWAIN WATER WELL SERVICE WAYNE
 RT. 2, BOX 37 county well located

LANDOWNER:
 Glynn Sanderson
 Waynesboro Ms.
 (mailing address)

WELL LOCATION:
 sec. 7 T 9 N R 7 E
 5 miles SW of Waynesboro
 (distance) (direction) (nearest town)

WELL PURPOSE: Home
 (home, irrigation, municipal, industrial)

WELL COMPLETION DATA:
 (1) diameter (inches) 2"
 (2) total depth (feet) 73'
 (3) static water level (feet) 43' below top of ground.
 (4) casing PVC 68' (material) (depth)
 2" (size) if telescope see back.
 (5) screen 5' 68' (length) (depth to top)
 2" PVC .008 (size) (material)
 (6) pump 1 10 (HP) (yield gpm)
 220 AC (type power)
 (7) electric log No (yes or no)
 (organization running log)


description of formations encountered	from	to
Red Sandy Clay	0	10
Red Sand	10	14
Sand + Clay	14	30
Clay	30	35
Sand + Clay	35	43
Clay	43	58
Medium Coarse Sand	58	73

RECEIVED
 JUN 12 1978
 MISSISSIPPI BOARD OF WATER COMMISSIONERS

DRILLERS REMARKS:

If well telescopes please sketch and show depths.

GROUND LEVEL

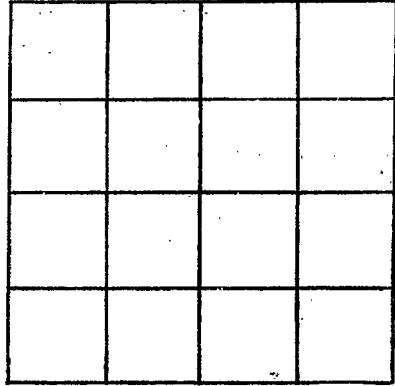

SECTION _____

Please indicate well location X.

ADDITIONAL INFORMATION

If more than one screen,
show locations of each on sketch.