

WAYNE
H 2030
12-11-78

**MISSISSIPPI
BOARD OF WATER COMMISSIONERS**
416 North State Street
Jackson, Mississippi 39201

WATER WELL DRILLERS LOG

Dec. 11 1978 date well completed
 McILWAIN WATER WELL SERVICE WAYNE
 RT. 12m near BOX 37
 county well located
 WAYNESBORO, MISS. 39367


LANDOWNER:	description of formations encountered	from	to
Bruce Doherty Waynesboro (mailing address)			
WELL LOCATION:	Red Sand & Clay	12	20
sec. 17 T. 9 N R. 7 E 7 miles NW of Wboro (distance) (direction) (nearest town)	Fine Sand	20	25
WELL PURPOSE: FARM (home, irrigation, municipal, industrial)	COARSE SAND	25	40
WELL COMPLETION DATA:			
(1) diameter (inches) 2"			
(2) total depth (feet) 40'			
(3) static water level (feet) 28' below top of ground.			
(4) casing PVC 35' (material) (depth) 2" (size) if telescope see back.			
(5) screen 5' 35' (length) (depth to top) 2" PVC. 008 (size) (material)			
(6) pump 1 (HP) 10 (yield gpm) 220 AC (type power)			
(7) electric log No (yes or no)			
(organization running log)			
(8) how well bottom plugged			
DRILLERS REMARKS:			

RECEIVED
JAN 10 1978

MISS. BD. OF WATER COMM.

If well telescopes please sketch and show depths.

GROUND LEVEL

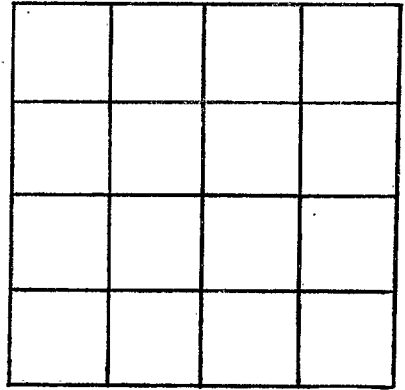

SECTION _____

Please indicate well location X.

ADDITIONAL INFORMATION

If more than one screen,
show locations of each on sketch.