

WAYNE  
 H 2057  
 2-25-78

MISSISSIPPI  
 BOARD OF WATER COMMISSIONERS  
 416 North State Street  
 Jackson, Mississippi 39201

WATER WELL DRILLERS LOG

Oct 25 1978 Boyer Drilling & Log Wayne  
 date well completed firm name county well located

LANDOWNER: <u>John Street</u>	description of formations encountered	from	to
<u>RL 1 Uniontown Miss</u> (mailing address)	<del>clay</del> clay	0	20
WELL LOCATION: sec <u>30</u> T <u>9</u> N R <u>7</u> W <u>6</u> miles <u>NW</u> of <u>Haywood</u> (distance) (direction) (nearest town)	Cement concrete gravel	20	50
WELL PURPOSE: <u>Home</u> (home, irrigation, municipal, industrial)	fine sand	50	76
WELL COMPLETION DATA:	hard coarse sand	76	90
(1) diameter (inches) <u>2"</u>	clay and white shell		
(2) total depth (feet) <u>90'</u>	in sand		
(3) static water level (feet) <u>57</u> (below/above top of ground)	6 to 1" P.V.C. down pipe		
(4) casing <u>P.V.C.</u> <u>8.5'</u> (material) (depth)			
<u>2"</u> (size) if telescope see back.			
(5) screen <u>5'</u> <u>8.5'</u> (length) (depth to top)			
<u>2"</u> (size) <u>galv. P.V.C.</u> (material)			
(6) pump <u>3/4</u> <u>7</u> (HP) (yield gpm)			
<u>elec</u> (type power)			
(7) electric log <u>no</u> (yes or no)			
(organization running log)			
(8) how well bottom plugged <u>1/4" back wash valve</u>			
DRILLERS REMARKS:			


Miss. Board of Water Comm

FEB 8 1979

RECEIVED

If well telescopes please sketch and show depths.

GROUND LEVEL

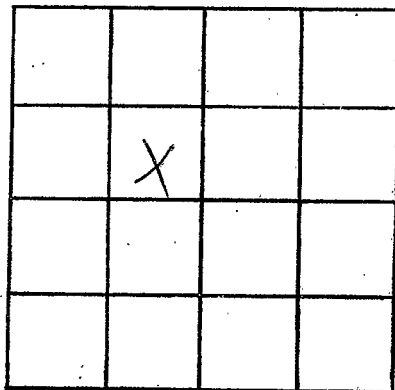

SECTION 30

Please indicate well location X.

ADDITIONAL INFORMATION

If more than one screen,  
show locations of each on sketch.