

WAYNE
 H 2038
 1-01-79

MISSISSIPPI
 BOARD OF WATER COMMISSIONERS
 416 North State Street
 Jackson, Mississippi 39201

WATER WELL DRILLERS LOG

McILWAIN WATER WELL SERVICE

WAYNE

JAN. 1 19 79 date well completed
 RT. 2 BOX 37 firm name
 WAYNESBORO MISS. 39367 county well located

LANDOWNER:	description of formations encountered	from	to
John LEE	Brown Sand	0	5
Waynesboro Miss (mailing address)	Clay	5	10
WELL LOCATION: sec. 26 T 9 N R 7 E 2 miles NW of W'boro (distance) (direction) (nearest town)	SAND	10	26
WELL PURPOSE: FARM (home, irrigation, municipal, industrial)			
WELL COMPLETION DATA:			
(1) diameter (inches) 2"			
(2) total depth (feet) 26'			
(3) static water level (feet) 20' below top of ground.			
(4) casing PVC 21' (material) (depth) 2" (size) if telescope see back.			
(5) screen 5' 21' (length) (depth to top) 2" PVC .008 (size) (material)			
(6) pump 1/2 7 1/2 (HP) (yield gpm) 110 AC (type power)			
(7) electric log NO (yes or no) (organization running log)			
(8) how well bottom plugged			

Miss. Board of Water Comm.


MAR 5 - 1979

RECEIVED

DRILLERS REMARKS:

If well telescopes please sketch and show depths.

GROUND LEVEL

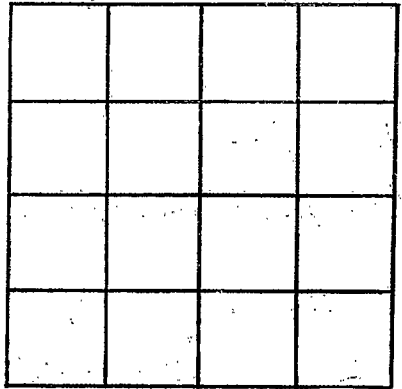

SECTION _____

Please indicate well location X.

ADDITIONAL INFORMATION

If more than one screen,
show locations of each on sketch.