

WAYNE  
H 2039  
5-31-79

MISSISSIPPI  
BOARD OF WATER COMMISSIONERS  
416 North State Street  
Jackson, Mississippi 39201

WATER WELL DRILLERS LOG  
McILWAIN WATER WELL SERVICE

5-31-79  
date well completed

RT 2 BOX 37  
firm name  
WAYNESBORO, MISS. 39367

Wayne  
county well located


LANDOWNER:	description of formations encountered	from	to
G.P. Doherty Waynesboro, Ms. (mailing address)			
WELL LOCATION:	Red SANDY CLAY	5	8
sec. 6 T 9 N R 7 E 8 miles NW of W'boro (distance) (direction) (nearest town)	Red SAND	8	22
WELL PURPOSE: home (home, irrigation, municipal, industrial)	COARSE SAND	22	35
WELL COMPLETION DATA:	Med. COARSE SAND	35	54
(1) diameter (inches) 2"	CLAY	54	55
(2) total depth (feet) 85'	SAND + some CLAY	55	65
(3) static water level (feet) 72' below top of ground.	COARSE SAND	65	85
(4) casing PVC 80' (material) (depth) 2" (size) if telescope see back.			
(5) screen 5' 80' (length) (depth to top) 2" PVC-008 (size) (material)			
(6) pump 1 6 (HP) (yield gpm) 220 AC (type power)			
(7) electric log NO (yes or no)			
(organization running log)			
(8) how well bottom plugged			

Miss. Board of Water Comm.  
JUN 14 1979  
RECEIVED  
McILWAIN

DRILLERS REMARKS:

If well telescopes please sketch and show depths.

GROUND LEVEL

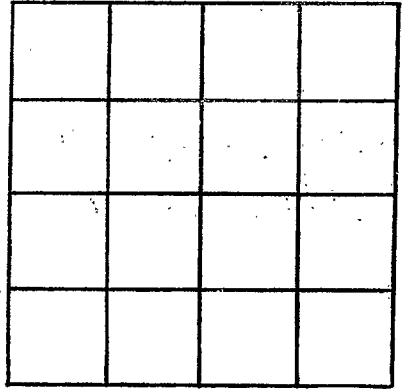

SECTION \_\_\_\_\_

Please indicate well location X.

ADDITIONAL INFORMATION

If more than one screen,  
show locations of each on sketch.