

WAYNE
H 2040
5/30/79

MISSISSIPPI
BOARD OF WATER COMMISSIONERS
416 North State Street
Jackson, Mississippi 39201

WATER WELL DRILLERS LOG
MCGILWAIN WATER WELL SERVICE

5-30-79
date well completed

PT. 2, BOX 37
WAYNESBORO, MISS. 39367

Wayne
county well located

LANDOWNER:
James J. Brown
Waynesboro, Ms.
(mailing address)

description of formations encountered	from	to
Red SAND	0	25
CLAY	25	34
SANDY Red & CLAY	34	38
CLAY	38	41
SAND	41	43
CLAY	43	45
SAND	45	83
CLAY	83	87
COARSE SAND	87	120

WELL LOCATION:
sec. 18 T 9 N R 7 E
7 miles NW of W.boro
(distance) (direction) (nearest town)

WELL PURPOSE: home
(home, irrigation, municipal, industrial)

- WELL COMPLETION DATA:
- (1) diameter (inches) 2"
 - (2) total depth (feet) 120'
 - (3) static water level (feet) 91' below top of ground.
 - (4) casing PVC, 115' (material) (depth)
2" (size) if telescope see back.
 - (5) screen 5' 115' (length) (depth to top)
2" PVC .008 (size) (material)
 - (6) pump 1/2 5 (HP) (yield gpm)
220AC (type power)
 - (7) electric log NO (yes or no)

(organization running log)

(8) how well bottom plugged

DRILLERS REMARKS:


Miss. Board of Water Comm.

JUN 14 1979

RECEIVED

If well telescopes please sketch and show depths.

GROUND LEVEL

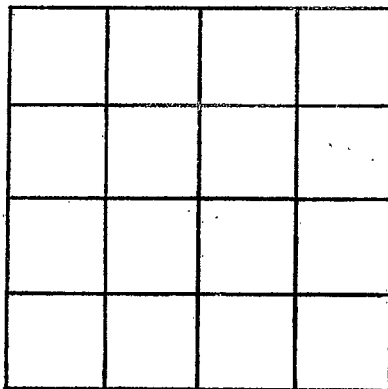

SECTION _____

Please indicate well location X.

ADDITIONAL INFORMATION

If more than one screen,
show locations of each on sketch.