

WAYNE
H 204
8-4-79

MISSISSIPPI
BOARD OF WATER COMMISSIONERS
416 North State Street
Jackson, Mississippi 39201

WATER WELL DRILLERS LOG

McILWAIN WATER WELL SERVICE

8-4 19 79 date well completed
 BOX 27
 firm name
 39367 county well located

LANDOWNER:
 Tommy Davis
 Waynesboro Miss
 (mailing address)

description of formations encountered	from	to
Red Sandy Clay	0	15
Red Sand & Gravel	15	25
White Sand & Gravel	25	52
White Sand	52	62

WELL LOCATION:
 sec. 8 T. 9 N R. 7 E
 8 miles NW of Wboro
 (distance) (direction) (nearest town)

WELL PURPOSE: Home
 (home, irrigation, municipal, industrial)

WELL COMPLETION DATA:

(1) diameter (inches) 2"

(2) total depth (feet) 62'

(3) static water level (feet) 49' below top of ground

(4) casing (material) (depth) 2" 56'
 2" If telescope see back.
 (size)

(5) screen (length) (depth to top) 6' 56'
 2" PVC .008
 (size) (material)

(6) pump (HP) (yield gpm) 1 8

VIDAC
 (type power)

(7) electric log No
 (yes or no)

(organization running log)

(8) how well bottom plugged

Miss. Board of Water Comm.


AUG 9 1979

DRILLERS REMARKS:

RECEIVED

If well telescopes please sketch and show depths.

GROUND LEVEL

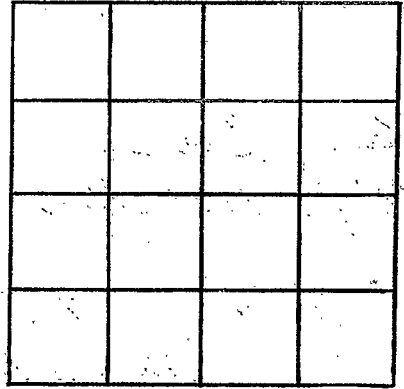

SECTION _____

Please indicate well location X.

ADDITIONAL INFORMATION

If more than one screen,
show locations of each on sketch.