

Wayne
H 2042
8-27-79

MISSISSIPPI
 BOARD OF WATER COMMISSIONERS
 416 North State Street
 Jackson, Mississippi 39201

WATER WELL DRILLERS LOG

Aug 27 1979 Porter Drilling Wayne
 date well completed firm name county well located

LANDOWNER: Cary Graham
Box 1
Shubuta, Miss
 (mailing address)

description of formations encountered	from	to
<u>Clay & sand</u>	<u>0</u>	<u>27</u>
<u>clay</u>	<u>27</u>	<u>35</u>
<u>clay & sand</u>	<u>35</u>	<u>45</u>
<u>small sand</u>	<u>45</u>	<u>60</u>
<u>stop on clay</u>		

WELL LOCATION:
 sec. 6 T 9 (N) R 7 (E)
7 miles NW of Waynesboro
 (distance) (direction) (nearest town)

WELL PURPOSE: Home
 (home, irrigation, municipal, industrial)

52' 1" P.V.C drop pipe

- WELL COMPLETION DATA:
- (1) diameter (inches) 2"
 - (2) total depth (feet) 59'
 - (3) static water level (feet) 40' below top of ground.
 - (4) casing P.V.C, 55'
 (material) (depth)
2"
 (size) If telescope see back.
 - (5) screen 4, 55'
 (length) (depth to top)
1/2", 6 salt 55'
 (size) (material)
 - (6) pump 1, 10
 (HP) (yield gpm)
elec.
 (type power)
 - (7) electric log no
 (yes or no)

(organization running log)

(8) how well bottom plugged
1/2" sand blank

DRILLERS REMARKS:


Miss. Board of Water Comm.

SEP 10 1979

RECEIVED

If well telescopes please sketch and show depths.

GROUND LEVEL

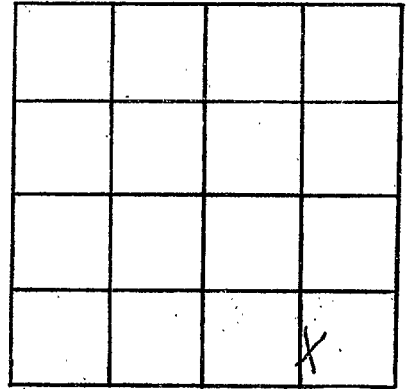

SECTION 6

Please indicate well location X.

ADDITIONAL INFORMATION

If more than one screen,
show locations of each on sketch.