

WAYNE  
H 2043  
3/11/80

MISSISSIPPI  
BOARD OF WATER COMMISSIONERS  
416 North State Street  
Jackson, Mississippi 39201

WATER WELL DRILLERS LOG

March 11 1980 date well completed  
Porter Drilling & Pipe firm name  
Wayne county well located

LANDOWNER: Silver Creek  
Silver Dome  
241 W. Magnolia Ave.  
(mailing address)

description of formations encountered	from	to
top soil & sand	0	8
clay	8	32
Richardson rocks	32	56
white clay	56	75
white clay with rock	75	90
blue clay	90	95

WELL LOCATION:  
sec. 12 T 9 N R 7 E  
S W  
5 miles NW of Waynesboro  
(distance) (direction) (nearest town)

WELL PURPOSE: Silver Dome  
(home, irrigation, municipal, industrial)

WELL COMPLETION DATA:

(1) diameter (inches) 2 1/2

(2) total depth (feet) 95

(3) static water level (feet) 18 below top of ground.

(4) casing steel 80 (material) (depth)  
2 1/2 (size) if telescope see back.

(5) screen wire mesh (length) (depth to top)  
(size) (material)

(6) pump 1 15 (HP) (yield gpm)  
elec. (type power)

(7) electric log no (yes or no)  
(organization running log)


(8) how well bottom plugged open

DEPT. OF NATURAL RESOURCES  
BUREAU OF LAND & WATER RESOURCES  
MAR 18 1980  
RECEIVED

DRILLERS REMARKS: 3 way  
bushing set at 39' in  
reworked hole  
63' 1/4 galv. down pipe

If well telescopes please sketch and show depths.

GROUND LEVEL

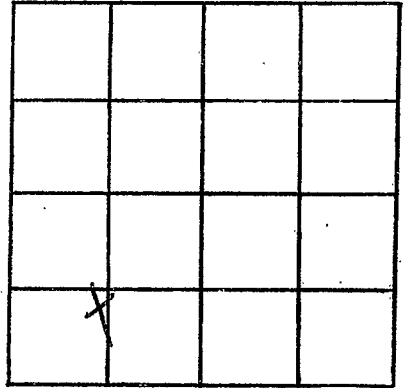

SECTION 18

Please indicate well location X.

ADDITIONAL INFORMATION

If more than one screen,  
show locations of each on sketch.