

MISSISSIPPI DEPARTMENT OF NATURAL RESOURCES

Bureau of Land and Water Resources

Southport Mall

P.O. Box 10631

Jackson, Mississippi 39209

WATER WELL DRILLERS LOG

WAY
H 2045
7-11

July 11 1980 date well completed
Porter-Drilling & Log firm name
Wayne county well located

LANDOWNER: Mrs Robert Long
At 1 Waynesboro Miss
(mailing address)

description of formations encountered	from	to
sand & clay	0	65
clay	65	88
lean sand & clay	88	103
clay	103	109
socket strator	109	147
clay	147	177
shellsburg rock	177	210

WELL LOCATION:
sec 29 T 9 (N) R 7 (E) S (W)
3 miles (distance) NW (direction) of Waynesboro (nearest town)

WELL PURPOSE: home
(home, irrigation, municipal, industrial)

WELL COMPLETION DATA:

- (1) diameter (inches) 2
- (2) total depth (feet) 210
- (3) static water level (feet) 128 below top of ground.
- (4) casing steel (material) 178 (depth)
2" (size) if telescope see back.
- (5) screen none used (length) (depth to top)
- (6) pump 2 (HP) 6 (yield gpm)
elec (type power)
- (7) electric log no (yes or no)

(organization running log)

(8) how well bottom plugged open


DRILLERS REMARKS:

147' 1 1/2" galv. drive pipe

DEPT OF NATURAL RESOURCES
BUREAU OF LAND & WATER RESOURCES
SEP 24 1980
RECEIVED

If well telescopes please sketch and show depths.

GROUND LEVEL

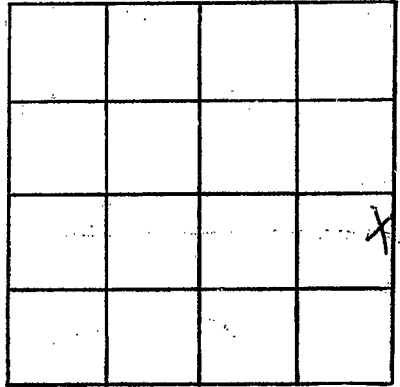

SECTION 29

Please indicate well location X.

ADDITIONAL INFORMATION

If more than one screen,
show locations of each on sketch.