

MISSISSIPPI DEPARTMENT OF NATURAL RESOURCES

Bureau of Land and Water Resources

Southport Mall

P.O. Box 10631

Jackson, Mississippi 39209

WATER WELL DRILLERS LOG

WAYNE  
H 2046  
10-22-80

Oct 22 1980 Porto Drilling & Log Wayne  
date well completed firm name county well located

LANDOWNER: <u>Bruce Stokerly</u>	description of formations encountered	from	to
<u>At 1 Waynesboro</u> (mailing address)	<u>clay &amp; sand</u>	<u>0</u>	<u>18</u>
	<u>sand</u>	<u>18</u>	<u>68</u>
	<u>clay &amp; sand</u>	<u>68</u>	<u>75</u>
WELL LOCATION: sec. <u>8</u> T. <u>9</u> N. R. <u>7</u> E <u>5</u> miles <u>NW</u> of <u>Waynesboro</u> (distance) (direction) (nearest town)			
WELL PURPOSE: <u>chicken house</u> (home, irrigation, municipal, industrial)	<u>66' 1" P.V.C. drop pipe</u>		
WELL COMPLETION DATA:	<u>and 5' 1" tail pipe</u>		
(1) diameter (inches) <u>2</u>	<u>below jet.</u>		
(2) total depth (feet) <u>72'</u>	<u>no shell trap</u>		
(3) static water level (feet) <u>63</u> <u>below</u> <u>above</u> top of ground.			
(4) casing <u>P.V.C.</u> <u>67'</u> (material) (depth)			
<u>2"</u> (size) if telescope see back.			
(5) screen <u>5'</u> <u>67'</u> (length) (depth to top)			
<u>2"</u> <u>8 slot P.V.C.</u> (size) (material)			
(6) pump <u>1</u> <u>4</u> (HP) (yield gpm)			
<u>elec</u> (type power)			
(7) electric log <u>no</u> (yes or no)			
<u></u> (organization running log)			
(8) how well bottom plugged <u>2' sand shark</u>			
DRILLERS REMARKS: <u></u>			


DEPT. OF NATURAL RESOURCES  
BUREAU OF LAND & WATER RESOURCES

DEC - 2 1980

RECEIVED

If well telescopes please sketch and show depths.

GROUND LEVEL

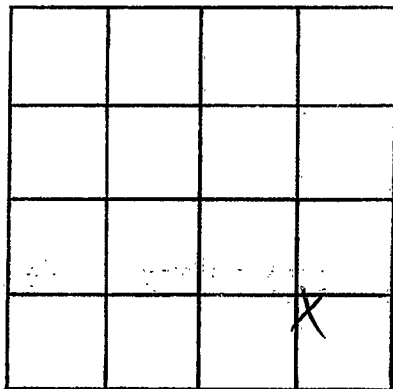

SECTION 2

Please indicate well location X.

ADDITIONAL INFORMATION

If more than one screen,  
show locations of each on sketch.