

MISSISSIPPI DEPARTMENT OF NATURAL RESOURCES

Bureau of Land and Water Resources

Southport Mall

P.O. Box 10631

Jackson, Mississippi 39209

WATER WELL DRILLERS LOG

WAYNE
H 2048
1/26/81

Jan 26 1981 date well completed
Roster Drilling & Log firm name
Wayne county well located

LANDOWNER:

Shilly Robert

description of formations encountered

from

to

Mc Kee

At 1 Starnesboro Miss
(mailing address)

clay	0	22
lime gravel	22	26
100s	26	38
sand & clay	38	53
med sand	53	66
stagnant water		
still in sand		

WELL LOCATION:

sec. 29 T 9 N R 7 E
3 miles NW of Starnesboro (distance) (direction) (nearest town)

WELL PURPOSE: home
(home, irrigation, municipal, industrial)

WELL COMPLETION DATA:

42' 1" P.V.C. drop pipe

- (1) diameter (inches) 2"
- (2) total depth (feet) 66'
- (3) static water level (feet) 25' below top of ground
- (4) casing PVC 61' (material) (depth)
2" (size) if telescope see back.
- (5) screen 5' 61' (length) (depth to top)
2" (size) 6' bet S.S. (material)
- (6) pump 1 12 (HP) (yield gpm)
elec (type power)
- (7) electric log no (yes or no)

(organization running log)


(8) how well bottom plugged
2" back wash valve

DRILLERS REMARKS:

DEPT. OF NATURAL RESOURCES
BUREAU OF LAND & WATER RESOURCES
MAR 3 1981
RECEIVED

If well telescopes please sketch and show depths.

GROUND LEVEL

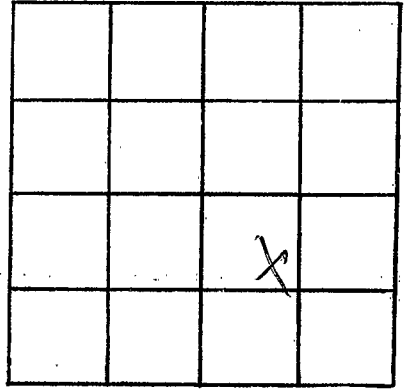

SECTION 29

Please indicate well location X.

ADDITIONAL INFORMATION

If more than one screen,
show locations of each on sketch.