

WAYNE  
H 2049  
3/20/81

BOARD OF WATER COMMISSIONERS  
416 North State Street  
Jackson, Mississippi 39201

WATER WELL DRILLERS LOG

March 20 1981 St. Roy V. West Drlg firm name WAYNE county well located  
date well completed


LANDOWNER:	description of formations encountered	from	to
CARL Lofton	CLAY	0	60
	SAND	60	80
	CLAY	80	100
(mailing address)	CLAY, ROCK STR	100	115
	LIME STONE	150	200
WELL LOCATION:			
sec. <u>23</u> T <u>8</u> N R <u>7</u> E			
<u>3</u> miles <u>NW</u> of <u>Waynesboro</u>			
(distance) (direction) (nearest town)			
WELL PURPOSE: <u>HOME</u>			
(home, irrigation, municipal, industrial)			
WELL COMPLETION DATA:			
(1) diameter (inches) <u>4"</u>			
(2) total depth (feet) <u>200'</u>			
(3) static water level (feet) <u>110'</u> <sup>below</sup> / <sub>above</sub> top of ground.			
(4) casing <u>PVC</u> <u>150'</u>			
(material) (depth)			
(size) If telescope see back.			
(5) screen <u>NONE</u>			
(length) (depth to top)			
(size) (material)			
(6) pump <u>1/2</u> <u>8</u>			
(HP) (yield gpm)			
<u>REA</u>			
(type power)			
(7) electric log <u>NO</u>			
(yes or no)			
(organization running log)			
(8) how well bottom plugged <u>OPEN END</u>			
DRILLERS REMARKS:			

DEPT. OF NATURAL RESOURCES  
BUREAU OF LAND & WATER RESOURCES

MAY 19 1981

RECEIVED

GROUND LEVEL

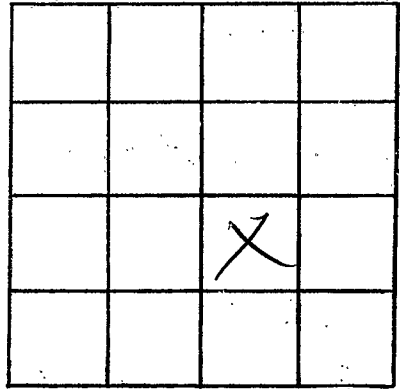

SECTION 33

Please indicate well location X.

ADDITIONAL INFORMATION

If more than one screen,  
show locations of each on sketch.