

MISSISSIPPI DEPARTMENT OF NATURAL RESOURCES

Bureau of Land and Water Resources

Southport Mall

P.O. Box 10631

Jackson, Mississippi 39209

WATER WELL DRILLERS LOG

WAYNE
H-2050
6-23-81

June 23 1981 Booby Drilling Inc Wayne
 date well completed firm name county well located

LANDOWNER: Bobby Bunch
Part 1
Waynesboro Miss
 (mailing address)

WELL LOCATION:
 sec 20 T 9 N R 7 E
4 1/2 miles NW Waynesboro
 (distance) (direction) (nearest town)

WELL PURPOSE: home
 (home, irrigation, municipal, industrial)

WELL COMPLETION DATA:

(1) diameter (inches) 2"

(2) total depth (feet) 89'

(3) static water level (feet) 76' (below/above top of ground)

(4) casing PVC 82'
 (material) (depth)
2" If telescope see back.
 (size)


(5) screen 5' 82'
 (length) (depth to top)
2" salt P.V.C
 (size) (material)

(6) pump 1 5
 (HP) (yield gpm)
elec
 (type power)

(7) electric log no
 (yes or no)

(8) how well bottom plugged
2' sand/salts


description of formations encountered	from	to
<u>sand</u>	<u>0</u>	<u>9</u>
<u>clay</u>	<u>9</u>	<u>22</u>
<u>sand clay near ground</u>	<u>22</u>	<u>60</u>
<u>sandy silty</u>	<u>60</u>	<u>85</u>
<u>clay</u>	<u>85</u>	<u>96</u>
<u>salt clay sand</u>	<u>96</u>	<u>103</u>
<u>clay</u>	<u>103</u>	<u>105</u>
<u>81' 1" P.V.C drop pipe</u>		
<u>2' 2" P.V.C lat pipe below screen with blank end on end & shell tags above screen</u>		

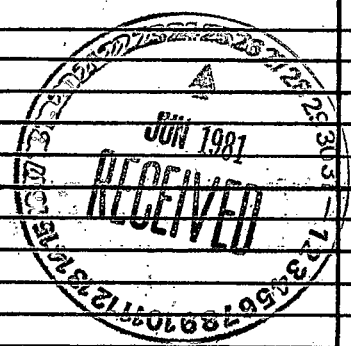

DRILLERS REMARKS:

If well telescopes please sketch and show depths.

GROUND LEVEL

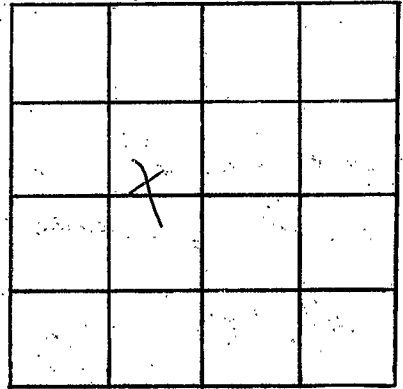

SECTION 20

Please indicate well location X.

ADDITIONAL INFORMATION

If more than one screen,
show locations of each on sketch.