

MISSISSIPPI DEPARTMENT OF NATURAL RESOURCES

Bureau of Land and Water Resources

Southport Mall

P.O. Box 10631

Jackson, Mississippi 39209

WATER WELL DRILLERS LOG

Wayne  
H 2052  
9-14-81

Sept 14 1981 date well completed  
31 Boster Drilling & Log firm name  
Wayne county well located

LANDOWNER: Burl Odum  
Pt 1  
Waynesboro, Miss  
(mailing address)

description of formations encountered	from	to
<u>red clay</u>	<u>0</u>	<u>1.5</u>
<u>sand</u>	<u>1.5</u>	<u>69</u>
<u>stopped on clay</u>		

WELL LOCATION:  
sec. 8 T 9 N R 7 E  
6 miles NW of Waynesboro  
(distance) (direction) (nearest town)

60' 1" P.V.C. drop pipe


WELL PURPOSE: home  
(home, irrigation, municipal, industrial)

- WELL COMPLETION DATA:
- (1) diameter (inches) 2"
  - (2) total depth (feet) 69'
  - (3) static water level (feet) 48' below above top of ground.
  - (4) casing P.V.C. 64'  
(material) (depth)
  - 2' if telescope see back.  
(size)
  - (5) screen 5' 64'  
(length) (depth to top)
  - 2" 64' galv SS.  
(size) (material)
  - (6) pump 1 10  
(HP) (yield gpm)
  - dec.  
(type power)
  - (7) electric log no  
(yes or no)
  - (organization running log)
  - (8) how well bottom plugged 2' sand shank

SEPT. OF NATURAL RESOURCES  
BUREAU OF LAND & WATER RESOURCES

SEP 18 1981


RECEIVED

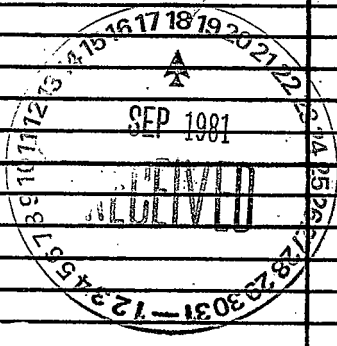

DRILLERS REMARKS:

If well telescopes please sketch and show depths.

GROUND LEVEL

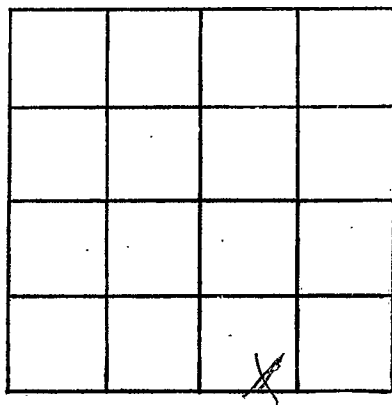

SECTION 8

Please indicate well location X.

ADDITIONAL INFORMATION

If more than one screen,  
show locations of each on sketch.