

MISSISSIPPI DEPARTMENT OF NATURAL RESOURCES

Bureau of Land and Water Resources

Southport Mall

P.O. Box 10631

Jackson, Mississippi 39209

WATER WELL DRILLERS LOG

Wayne
H 2053
10-13-81

Oct 13 1981 Porter Drilling & Log Wayne
 date well completed firm name county well located

LANDOWNER Cabin Breakers
Box 1 Waynesboro
Miss.
 (mailing address)

WELL LOCATION:
 sec 20 T 9 N R 7 W
4 miles NW of Waynesboro
 (distance) (direction) (nearest town)

WELL PURPOSE: home
 (home, irrigation, municipal, industrial)

WELL COMPLETION DATA:

(1) diameter (inches) 2"

(2) total depth (feet) 109'

(3) static water level (feet) 58' below above top of ground.

(4) casing P.V.C. 104'
 (material) (depth)
2" If telescope see back.
 (size)

(5) screen 5' 104'
 (length) (depth to top)
2" brist SS.
 (size) (material)

(6) pump 1 9
 (HP) (yield gpm)
elec
 (type power)

(7) electric log no
 (yes or no)

(organization running log)

description of formations encountered	from	to
sand	0	6
clay	6	41
sh. rock		41
sand & clay	41	65
sand	65	75
fine sand & clay	75	88
loose sand	88	106
thin sand	106	110
interjection rock		

78' 1" P.V.C. drop pipe

DEPT. OF NATURAL RESOURCES
 BUREAU OF LAND & WATER RESOURCES

NOV 24 1981


RECEIVED

(8) how well bottom plugged
2" sand down to shell top

DRILLERS REMARKS:

If well telescopes please sketch and show depths.

GROUND LEVEL

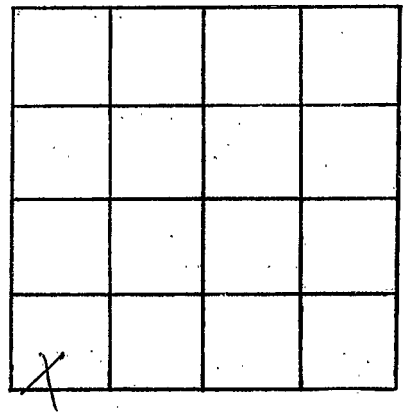

SECTION 20

Please indicate well location X.

ADDITIONAL INFORMATION

Lined area for additional information.

If more than one screen, show locations of each on sketch.