

MISSISSIPPI DEPARTMENT OF NATURAL RESOURCES

Bureau of Land and Water Resources

Southport Mall

P.O. Box 10631

Jackson, Mississippi 39209

WATER WELL DRILLERS LOG

WAYNE
H 2054
8-13-81

Aug 13 1981 Porter Drilling Shop Wayne
 date well completed firm name county well located

LANDOWNER: James Davis
Box 1 Waynesboro
Miss.
 (mailing address)

description of formations encountered	from	to
<u>sand</u>	<u>0</u>	<u>26</u>
<u>Wickelburg rock</u>	<u>26</u>	<u>40</u>
<u>lost circulation on top of rock</u>		
<u>28' 1/2" galv. drop pipe with 9 1/2' 1" tail pipe below jet</u>		

WELL LOCATION:
 sec 35 T 9 (N) R 7 E (W)
1 1/2 miles NW of Waynesboro
 (distance) (direction) (nearest town)

WELL PURPOSE: Home
 (home, irrigation, municipal, industrial)

- WELL COMPLETION DATA:
- (1) diameter (inches) 2
 - (2) total depth (feet) 40
 - (3) static water level (feet) 25 below top of ground.
 - (4) casing steel, 30'
 (material) (depth)
2' if telescope see back.
 (size)
 - (5) screen none used
 (length) (depth to top)
 (size) (material)
 - (6) pump 1 8
 (HP) (yield gpm)
elec.
 (type power)
 - (7) electric log no
 (yes or no)
 (organization running log)
 - (8) how well bottom plugged open

DRILLERS REMARKS:


MISSISSIPPI DEPT. OF NATURAL RESOURCES
 BUREAU OF LAND & WATER RESOURCES

SEP - 9 1981

RECEIVED

If well telescopes please
sketch and show depths.

GROUND LEVEL

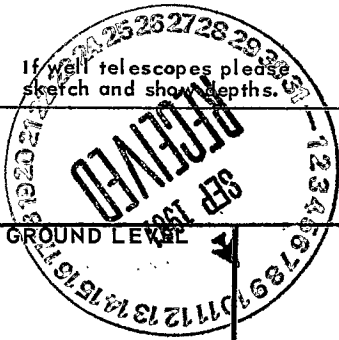

X			

SECTION 3.5

Please indicate well location X.

ADDITIONAL INFORMATION

If more than one screen,
show locations of each on sketch.