

MISSISSIPPI DEPARTMENT OF NATURAL RESOURCES

Bureau of Land and Water Resources

Southport Mall

P.O. Box 10631

Jackson, Mississippi 39209

WATER WELL DRILLERS LOG

Wayne
H5055

Dec 2 1981 Booth-Drilling & Log Wayne
date well completed firm name county well located

LANDOWNER: John C Lee
At 12 Haynesboro, Miss
(mailing address)

WELL LOCATION:
sec. 35 T 9 (N) R 7 E
12 miles NW of Waynesboro
(distance) (direction) (nearest town)

WELL PURPOSE: chicken house
(home, irrigation, municipal, industrial)

WELL COMPLETION DATA:

(1) diameter (inches) 2"

(2) total depth (feet) 60

(3) static water level (feet) 23 (below/above top of ground)

(4) casing steel 33'
(material) (depth)
2" If telescope see back.
(size)

(5) screen none used
(length) (depth to top)
(size) (material)

(6) pump 1 10
(HP) (yield gpm)
elec.
(type power)

(7) electric log no
(yes or no)
(organization running log)

(8) how well bottom plugged open sand

description of formations encountered	from	to
clay	0	6
smooth green gravel	6	23
clay	23	24
thick brown rocks	24	46
white clay stone rocks	46	60
<u>31' 1 1/2' galv. pipe</u>		

DEPT. OF NATURAL RESOURCES
BUREAU OF LAND & WATER RESOURCES


APR 20 1982

RECEIVED

DRILLERS REMARKS:

If well telescopes please sketch and show depths.

GROUND LEVEL

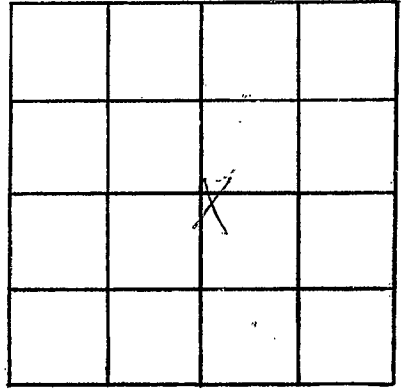

SECTION 35

Please indicate well location X.

ADDITIONAL INFORMATION

If more than one screen,
show locations of each on sketch.