

MISSISSIPPI DEPARTMENT OF NATURAL RESOURCES
Bureau of Land and Water Resources
 Southport Mall
 P.O. Box 10631
 Jackson, Mississippi 39209
WATER WELL DRILLERS LOG

Wayne
H
2057

5/17 1984 GRADY'S WELL SER WAYNE
 date well completed firm name county well located

LANDOWNER: GRADY JONES
P.O. 2 WAYNESBORO
MS. 39367
 (mailing address)

WELL LOCATION:
 sec 23 T 9N S R 7E W
6 miles E of WAYNESBORO
 (distance) (direction) (nearest town)

WELL PURPOSE:
 (home) irrigation, municipal, industrial

WELL COMPLETION DATA:


(1) diameter (inches) 2"
 (2) total depth (feet) 186
 (3) static water level (feet) 125 below above top of ground.
 (4) casing PVC 160'
 (material) (depth)
 (size) if telescope see back.
 (5) screen OPEN END
 (length) (depth to top)
 (size) (material)
 (6) pump 2 6
 (HP) (yield gpm)
ELEC.
 (type power)
 (7) electric log (yes or no)
 (organization running log) DEPT. OF LAND & WATER RESOURCES
 (8) how well bottom plugged OPEN

description of formations encountered	from	to
TOP SOIL		
RD. SDY. CLY.	0	1
CR. YEL. SD.	1	12
C. WHT. SD.	12	20
	20	22
YEL. CLY.	22	24
CR. YEL. SD.	24	26
ROCK + CLY	26	28
GRAY CLY.	28	53
CREAMY YEL. CLY.	53	55
CR. BR. SD	55	57
BLUE CLY.	57	72
CR. YEL. CLY.	72	75
MED. HARD ROCK	75	76
GRAY CLY.	76	78
MED. LIME R.	78	79
GRAY CLAY	79	89
HD. L. ROCK	89	91
MED. TO CR. LIME	91	95
GRAY SHALE	95	99
CLY.	99	122
MED. GRAY SD.	122	123
GRAY CLY.	123	126
MED GRAY SD.	126	128
LAYER BR. ROCK	128	130
GRAY Lumps	130	132
MED. HARD ROCK	132	133
DROPPER	133	134 1/2
CR. WHT. SD.	134	136 1/2
1 1/2" LAYER ROCK	136 1/2	137 1/2
MED "	137 1/2	141
HARD "	141	141 1/2
SOFT	141	142
H H I "	142	143
MED TO SOFT	143	148 1/2
H LAYER ROCK	148	149 1/2
MED. TO SOFT	149	152 1/2
H.D. LAYER ROC	152 1/2	153
MED. TO SOFT	153	156 1/2
H.D. LAYER ROCK	156 1/2	157 1/2
OVER		

JUN 11 1984
 DRILLERS REMARKS:
RECEIVED

If well telescopes please sketch and show depths.

GROUND LEVEL

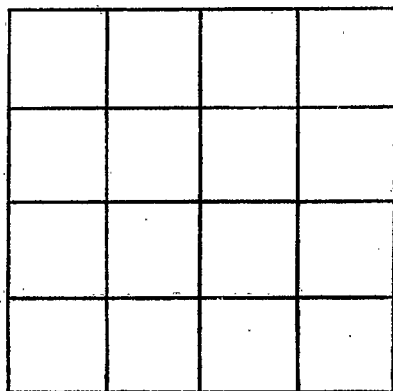

SECTION _____

Please indicate well location X.

ADDITIONAL INFORMATION

M.G.D. TO 50 FT 157 1/2 - 162
50 FT. LIME 162 - 176
M.G.P. 176 - 184
SPAY CLAY 184 - 186

If more than one screen, show locations of each on sketch.