

MISSISSIPPI DEPARTMENT OF NATURAL RESOURCES

Bureau of Land and Water Resources

Southport Mall

P.O. Box 10631

Jackson, Mississippi 39209

WATER WELL DRILLERS LOG

Wayne
H
2058

Sept. 20 19 84 Pat's Drilling Wayne
 date well completed firm name county well located

LANDOWNER: <u>Robert L Graham</u>	description of formations encountered	from	to
<u>211 Sh. Luta, Ms.</u> (mailing address)	<u>Clay + sand</u>	<u>0</u>	<u>15</u>
WELL LOCATION:	<u>with cover sand</u>	<u>15</u>	<u>26</u>
sec. <u>4</u> T <u>9</u> N R <u>7</u> E <u>2</u> miles <u>S</u> of <u>Thruance</u> (distance) (direction) (nearest town)	<u>with blue sand</u>	<u>26</u>	<u>30</u>
WELL PURPOSE: <u>cattle</u> (home, irrigation, municipal, industrial)	<u>thrust on clay</u> <u>would not produce in</u> <u>bottom part of sand</u>		
WELL COMPLETION DATA:			
(1) diameter (inches) <u>2"</u>			
(2) total depth (feet) <u>22'</u>			
(3) static water level (feet) <u>13'</u> <u>below</u> <u>above</u> top of ground.			
(4) casing <u>PVC</u> <u>17'</u> (material) (depth)			
<u>2"</u> (size) if telescope see back.			
(5) screen <u>5'</u> <u>17'</u> (length) (depth to top)			
<u>2"</u> <u>split PVC</u> (size) (material)			
(6) pump <u>pitch pump</u> <u>6</u> (HP) (yield gpm)			
(type power)			
(7) electric log (yes or no)			
(organization running log)			
(8) how well bottom plugged <u>metal plug</u>			
DRILLERS REMARKS:			


DEPT. OF NATURAL RESOURCES
 BUREAU OF LAND & WATER RESOURCES

OCT 22 1984

RECEIVED

If well telescopes please sketch and show depths.

GROUND LEVEL

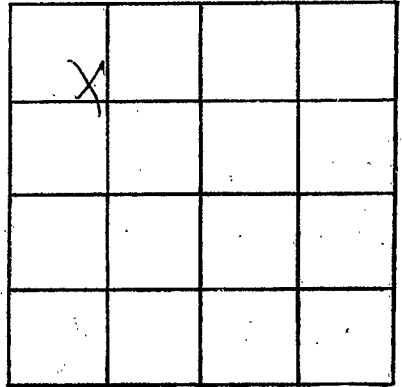

SECTION 4

Please indicate well location X.

ADDITIONAL INFORMATION

If more than one screen,
show locations of each on sketch.