

MISSISSIPPI DEPARTMENT OF NATURAL RESOURCES

Bureau of Land and Water Resources

P.O. Box 10631

Jackson, Mississippi 39209

WATER WELL DRILLERS LOG

COUNTY WELL LOCATED WAYNE	
WELL NUMBER H	CODED
2000	
DATE WELL COMPLETED 2/19/88	

PERMIT NUMBER 301
NAME OF DRILLING FIRM CARR'S WELL SER.
BOURBONNA, MS

NAME & MAILING ADDRESS OF LANDOWNER HOBERT HALL		
R.T.		
WAYNESBORO, MS. 39367		
WELL LOCATION: SEC	TOWNSHIP	RANGE
29	9	7
DISTANCE _____ Miles _____ of _____		
DIRECTION _____ NEAREST TOWN _____		
OTHER LANDMARK N NW WAYNESBORO Mi.		
WELL PURPOSE: Home, Irrigation, Municipal, Industrial, Fish Pond, etc.		

PUMP DATA		
PUMP TYPE (Circle One): Submersible, Turbine, Jet Flowing Well, Other (Describe) _____		
POWER TYPE (Circle One): Electric Tractor, Diesel, Gasoline, Butane, Other (Describe) _____		
Pump Capacity (GPM) 6	No. of Stages 2	Setting Depth 90 FT.
PUMP TEST		
Well yielded 10 GPM with a drawdown of 2 ft. after 2 hours of pumping		

WELL DATA		
Well Depth 153	Casing Diameter (In.) 2"	Casing Length (Ft.) 131
Type of Casing PVC	Hole Depth 153	Depth to Static Water Level 70'
TYPE OF COMPLETION: (Circle One or More): Gravel Packed, Underreamed, Telescoped, Natural Development , Open Hole, Other (Describe) _____		
Top of Lap Pipe or Reduction in Casing FEET IF TELESCOPED OR MORE THAN ONE SCREEN: USE BACK PAGE		

LOG DATA	
TYPE OF LOG RUN (Circle One): No Log Run, Electric, Gamma Ray, Density, Sonic, Neutron, Other (Describe) _____	
Name of Organization Running Log	

SCREEN DATA		
Diameter - Inches OPEN HOLE	Length - Feet	Slot Size - Inches
Screen Type	Depth to Bottom - Feet	

GEOLOGIC DATA (Office Use Only)			
Surface Elev.	Geologic Unit	Unit Thickness	Depth to Top
Subs. SWL	Date	Analysis	Aquifer Test


Driller's Remarks
RECEIVED

DESCRIPTION OF FORMATIONS ENCOUNTERED	FROM	TO	FORMATIONS (Continued)	FROM	TO	
SAND	0	3	APR 28 1988 Department of Natural Resources Bureau of Land & Water Resources			
CLAY & SD.	3	25				
BLUE CHALK	25	55				
ROCK	55	56				
BLUE CHALK	56	67				
ROCK STRATOR	67	90				
BLUE CHALK	90	120				
ROCK STRATOR	120	153				

IF MORE SPACE IS NEEDED, USE BACK

If well telescopes please sketch and show depths.

GROUND LEVEL

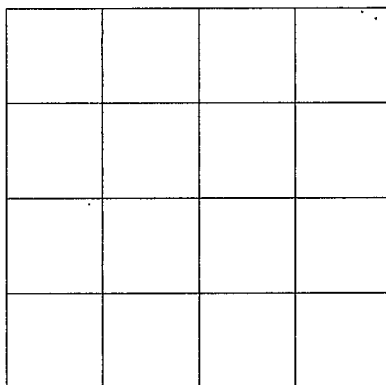

SECTION _____

Please indicate well location X.

ADDITIONAL INFORMATION

If more than one screen,
show location of each on sketch.