

MISSISSIPPI DEPARTMENT OF NATURAL RESOURCES

Bureau of Land and Water Resources

P.O. Box 10631

Jackson, Mississippi 39209

WATER WELL DRILLERS LOG

COUNTY WELL LOCATED WAYNE	
WELL NUMBER H	CODED
DATE WELL COMPLETED 9/26/88	

PERMIT NUMBER 205
NAME OF DRILLING FIRM CARR'S WELL SER
Bucklartanna, Ms.

NAME & MAILING ADDRESS OF LANDOWNER ARCHIE BASSETT		
RT. 1		
WAYNESBORO, MS 39269		
WELL LOCATION: SEC	TOWNSHIP	RANGE
20	9	7
	N	E
	S	W
DISTANCE	DIRECTION	NEAREST TOWN
6 Miles	N.W.	of WAYNESBORO
OTHER LANDMARK		
WELL PURPOSE: <input checked="" type="checkbox"/> Home, <input type="checkbox"/> Irrigation, <input type="checkbox"/> Municipal, <input type="checkbox"/> Industrial, <input type="checkbox"/> Fish Pond, etc.		

PUMP DATA		
PUMP TYPE (Circle One): Submersible, Turbine, <input checked="" type="radio"/> Jet, Flowing Well, Other (Describe) _____		
POWER TYPE (Circle One): Electric, Tractor, Diesel, Gasoline, Butane, Other (Describe) _____ H/P 2		
Pump Capacity (GPM) 8	No. of Stages 3	Setting Depth 114 FT.
PUMP TEST		
Well yielded 12 GPM with a drawdown of NONE ft. after 1 hours of pumping		

WELL DATA		
Well Depth 120	Casing Diameter (In.) 2 1/2	Casing Length (Ft.) 115
Type of Casing POC	Hole Depth 120	Depth to Static Water Level 100
TYPE OF COMPLETION: (Circle One or More): Gravel Packed, <input checked="" type="checkbox"/> Underreamed, <input type="checkbox"/> Telescoped, Natural Development, <input checked="" type="checkbox"/> Open Hole, <input type="checkbox"/> Other (Describe) _____		
Top of Lap Pipe or Reduction in Casing		
FEET	IF TELESCOPED OR MORE THAN ONE SCREEN: USE BACK PAGE	

LOG DATA	
TYPE OF LOG RUN (Circle One): No Log Run, Electric, Gamma Ray, Density, Sonic, Neutron, Other (Describe) _____	
Name of Organization Running Log	

SCREEN DATA		
Diameter - Inches 2 1/2	Length - Feet 5'	Slot Size - Inches 6
Screen Type STAINLESS STEEL	Depth to Bottom - Feet 120	


GEOLOGIC DATA (Office Use Only)			
Surface Elev.	Geologic Unit	Unit Thickness	Depth to Top
Subs. SWL	Date	Analysis	Aquifer Test
Driller's Remarks			

DESCRIPTION OF FORMATIONS ENCOUNTERED	FROM	TO	FORMATIONS (Continued)	FROM	TO
TOP SOIL	0	1	<div style="font-size: 2em; font-weight: bold; opacity: 0.5;">RECEIVED</div> <div style="font-size: 1.5em; font-weight: bold; margin-top: 10px;">OCT 13 1988</div> <div style="font-size: 0.8em; font-weight: bold; margin-top: 10px;">Department of Natural Resources Bureau of Land & Water Resources</div>		
SAND	1	24			
CHALK	24	60			
SAND	60	69			
CLAY	69	72			
SAND	72	75			
SAND & CLAY	75	96			
SAND	96	120			

IF MORE SPACE IS NEEDED, USE BACK

If well telescopes please sketch and show depths.

GROUND LEVEL

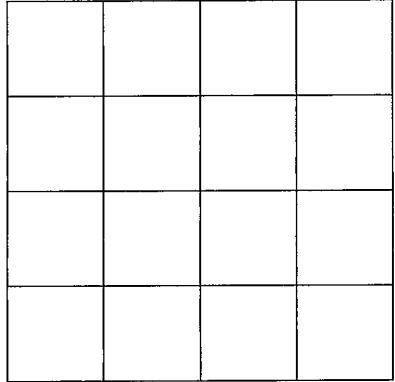

SECTION _____

Please indicate well location X.

ADDITIONAL INFORMATION

If more than one screen,
show location of each on sketch.