

Wayne
H 2072
10-17-75

MISSISSIPPI
 BOARD OF WATER COMMISSIONERS
 416 North State Street
 Jackson, Mississippi 39201

WATER WELL DRILLERS LOG

Oct 17 1975 Porter Drilling Co Wayne
 date well completed firm name county well located

LANDOWNER: Donnie Brewer - Northwood Dr. Wagnersboro Miss
 (mailing address)

description of formations encountered	from	to
clay	0	20
rock & shales	20	59
clay	59	61
sand	61	98
sand & clay	98	101
shales with	101	135

WELL LOCATION:
 sec 36 T 9 (N) R 7 (E) 13P
 + miles N Wagnersboro
 (distance) (direction) (nearest town)

WELL PURPOSE: Home
 (home, irrigation, municipal, industrial)

WELL COMPLETION DATA:
 (1) diameter (inches) 2"
 (2) total depth (feet) 135
 (3) static water level (feet) 65 below above top of ground.
 (4) casing steel, 103
 (material) (depth)
2' If telescope see back.
 (size)
 (5) screen iron, use 1
 (length) (depth to top)
 (size) (material)
 (6) pump 1 6
 (HP) (yield gpm)
elec.
 (type power)
 (7) electric log no
 (yes or no)
 (organization running log)
 (8) how well bottom plugged open

DRILLERS REMARKS:


84' 1" dry pipe

DEC - 4 1975

ATER COM

If well telescopes please sketch and show depths.

GROUND LEVEL

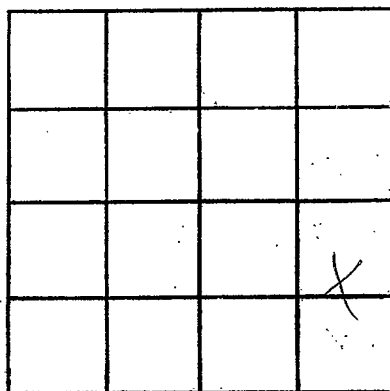

SECTION 36

Please indicate well location X.

ADDITIONAL INFORMATION

If more than one screen,
show locations of each on sketch.