

Wayne
H 223
10/20/75

MISSISSIPPI
 BOARD OF WATER COMMISSIONERS
 416 North State Street
 Jackson, Mississippi 39201

WATER WELL DRILLERS LOG

Oct 20 1975 Porter Drilling & Log Wayne
 date well completed firm name county well located

LANDOWNER: Wallace Byrd
Northwood Dr.

| description of formations encountered | from | to |
|---------------------------------------|------|-----|
| clay | 0 | 12 |
| rock strata | 12 | 32 |
| clay | 32 | 34 |
| sand | 34 | 64 |
| clay | 64 | 69 |
| the Helburg rock | 69 | 100 |

Magneshville Miss.
 (mailing address)

WELL LOCATION:
 sec. 36 T 9 N R 7 E 13P
1 miles N of Magneshville
 (distance) (direction) (nearest town)

WELL PURPOSE: Home
 (home, irrigation, municipal, industrial)

WELL COMPLETION DATA:

- (1) diameter (inches) 2"
- (2) total depth (feet) 100'
- (3) static water level (feet) 40' ^(below) _(above) top of ground.
- (4) casing steel 70'
 (material) (depth)
2' if telescope see back.
 (size)
- (5) screen none used
 (length) (depth to top)
 (size) (material)
- (6) pump 1 12
 (HP) (yield gpm)
elec
 (type power)
- (7) electric log no
 (yes or no)
 (organization running log)
- (8) how well bottom plugged open

DRILLERS REMARKS:


52' 1 1/2" drop pipe

DEC - 4 1975

MISS. DEP. OF WATER CONSERVATION

If well telescopes please sketch and show depths.

GROUND LEVEL

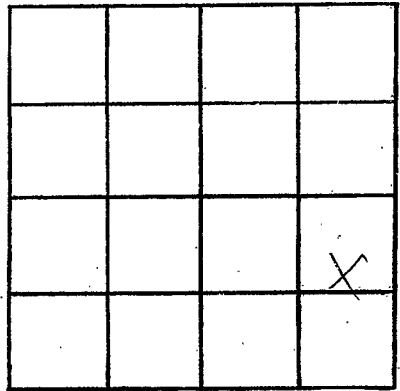

SECTION 36

Please indicate well location X.

ADDITIONAL INFORMATION

If more than one screen,
show locations of each on sketch.