

WAYNE MISSISSIPPI BOARD OF WATER COMMISSIONERS

J3

10-2-64

WATER WELL DRILLERS LOG

Date: Oct 2, 1964, Driller: Porter Drilling & Supply County Wayne
(Name)

(1) Owner of Land: Ralph Smith
(Name)
Rt 4 Waynesboro
(Address)

(2) Location: SW 1/4, NW 1/4, Sec 20 T9 R6
4 miles north, of Waynesboro
(distance) (direction) (Nearest Town)

(3) Topography: Hilly
(Hilly) (Flat) (Level)

(4) Purpose of Well: domestic
(Domestic Irrigation Municipal, Industrial, Other)

Description & Color of Materials Sand, Clay, Red Clay, Shell, etc.	Thick-ness Feet	Depth Feet
<u>red clay</u>	<u>15</u>	<u>15</u>
<u>red sand</u>	<u>23</u>	<u>38</u>
<u>chalk</u>	<u>4</u>	<u>42</u>
<u>sand & chalk</u>	<u>13</u>	<u>55</u>
<u>mostly chalk</u>	<u>8</u>	<u>63</u>
<u>chalk</u>	<u>7</u>	<u>70</u>
<u>sand mixed with chalk</u>	<u>7</u>	<u>77</u>

Information upon completion of well:

(1) Diameter 2" inches.

(2) Total Depth 77' feet.

(3) Water Level 65' feet below top of ground.

(4) Cased to 70', Size 2"


(5) Screen: Size 1 1/4, Length 5'
6 slot S.S.

(6) Were any formations sealed against pollution?
 yes, no.

If YES depth of formation _____

Why _____

Drillers Remarks: _____

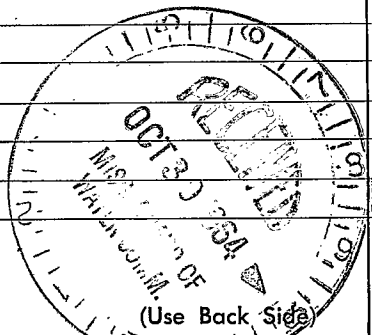

Well No. _____

