

WAYNE
J S

MISSISSIPPI BOARD OF WATER COMMISSIONERS

10-10-63

WATER WELL DRILLERS LOG

Date: Oct 10, 1963, Driller: Porter Drilling & Pipe County Wayne
(Name)

(1) Owner of Land: <u>Guy Walker</u> (Name)	Description & Color of Materials Sand, Clay, Red Clay, Shell, etc.	Thick-ness Feet	Depth Feet
<u>Rt 2 Waynesboro</u> (Address)	<u>red clay</u>	10	10
(2) Location: <u>SW 1/4, SE 1/4, Sec 31 T9.R6,</u>	<u>Chalk to sand, lumped</u>	23	33
<u>1</u> miles <u>north</u> , of <u>Waynesboro</u> (distance) (direction) (Nearest Town)	<u>sand</u>	12	45
(3) Topography: <u>hilly</u> (Hilly) (Flat) (Level)	<u>Chalk</u>	2	47
(4) Purpose of Well: <u>domestic</u> (Domestic Irrigation Municipal, Industrial, Other)	<u>fine sand lumped with chalk</u>	18	65
	<u>mod clean sand</u>	7	72

Information upon completion of well:

(1) Diameter 2" inches.

(2) Total Depth 72' feet.

(3) Water Level 47' feet below top of ground.


(4) Cased to 65', Size 2"

(5) Screen: Size 1 1/4", Length 6'

(6) Were any formations sealed against pollution?
 _____ yes, X no.

If YES depth of formation _____
 Why _____

Drillers Remarks: _____

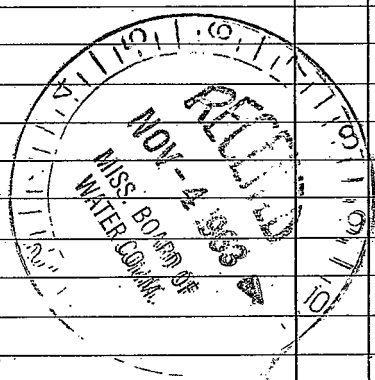

(Use Back Side)

Well No.

