

WAYNE MISSISSIPPI BOARD OF WATER COMMISSIONERS

J 9

11-27-64

WATER WELL DRILLERS LOG

Date: Nov 27, 1964, Driller: Porter Drilling & Supply County Wayne
 (Name)

~~Moreland Town location~~

(1) Owner of Land: Woland Clark
 (Name)

Waynesboro Miss
 (Address)

(2) Location: SW 1/4, SW 1/4, Sec. 31 T9 R6

1 miles N of Waynesboro
 (distance) (direction) (Nearest Town)

(3) Topography: hilly
 (Hilly) (Flat) (Level)

(4) Purpose of Well: domestic
 (Domestic Irrigation
 Municipal, Industrial, Other)

Description & Color of Materials Sand, Clay, Red Clay, Shell, etc.	Thick- ness Feet	Depth Feet
<u>red sand</u>	<u>30</u>	<u>30</u>
<u>red chalk</u>	<u>8</u>	<u>38</u>
<u>blue chalk</u>	<u>12</u>	<u>50</u>
<u>strata of lime rock</u>	<u>42</u>	<u>92</u>
<u>sand & chalk</u>	<u>8</u>	<u>100</u>
<u>mostly sand</u>	<u>5</u>	<u>105</u>
<u>med fine grey sand</u>	<u>7</u>	<u>112</u>
<u>stopped while still in sand</u>		

Information upon completion of well:

(1) Diameter 2" inches.

(2) Total Depth 112' feet.

(3) Water Level 92' feet below top of ground.

(4) Cased to 100', Size 2"

(5) Screen: Size 1/4", Length 6' 80ga


(6) Were any formations sealed against pollution?

yes, X no.

If YES depth of formation _____

Why _____

Drillers Remarks: _____

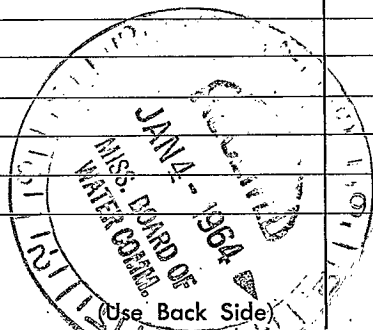

Well No. _____

