

WAYNE MISSISSIPPI BOARD OF WATER COMMISSIONERS

J 10

11-28-60

WATER WELL DRILLERS LOG

J-300

Date: Nov 28, 1960, Driller: D. N. Porter & Son County Wayne
(Name)

(1) Owner of Land: Billy L. Cochran
(Name)

Rt 4 Waynesboro, Miss
(Address)

(2) Location: SE 1/4, SE 1/4, Sec. 31 T9 R6,
2 miles N, of Waynesboro,
(distance) (direction) (Nearest Town)

(3) Topography: Hilly
(Hilly) (Flat) (Level)

(4) Purpose of Well: domestic
(Domestic Irrigation Municipal, Industrial, Other)

| Description & Color of Materials Sand, Clay, Red Clay, Shell, etc. | Thickness Feet | Depth Feet |
|---|----------------|------------|
| Clay | 12' | 12 |
| sand | 8" | 20 |
| chalk & layers of lime | | |
| rock | 60' | 80 |
| sand | 11' | 91' |
| stopped while still in sand | | |

Information upon completion of well:

(1) Diameter 2" inches.

(2) Total Depth 91' feet.

(3) Water Level 79' feet below top of ground.

(4) Cased to 84', Size 2"


(5) Screen: Size 1 1/4", Length 6'

(6) Were any formations sealed against pollution?
 _____ yes, X no.

If YES depth of formation _____

Why _____

Drillers Remarks: _____

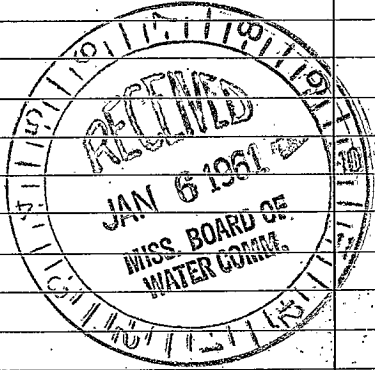

(Use Back Side)

Well No.

[The page contains extremely faint and illegible text, likely bleed-through from the reverse side of the document. The text is arranged in several vertical columns and is mostly unreadable.]