

Wayne  
 511  
 4-67

MISSISSIPPI  
 BOARD OF WATER COMMISSIONERS  
 416 North State Street  
 Jackson, Mississippi 39201

WATER WELL DRILLERS LOG

April 28 1967 Porter Drilling & Log Wayne  
 date well completed firm name county well located

LANDOWNER: David Stanley  
At 2 Haynesboro, Miss

description of formations encountered	from	to
<u>red sandy clay</u>	<u>0</u>	<u>8</u>
<u>sand</u>	<u>8</u>	<u>15</u>
<u>Chalk</u>	<u>15</u>	<u>44</u>
<u>red sand</u>	<u>44</u>	<u>53</u>
<u>course sand</u>	<u>53</u>	<u>57</u>


(mailing address)  
 WELL LOCATION:  
 sec 31 T 9 N R 6 E  
 S W  
1 miles NE of Haynesboro  
 (distance) (direction) (nearest town)

WELL PURPOSE: line  
 (home, irrigation, municipal, industrial)

WELL COMPLETION DATA:  
 (1) diameter (inches) 2"  
 (2) total depth (feet) 57'  
 (3) static water level (feet) 29' below above top of ground.  
 (4) casing steel 50'  
 (material) (depth)  
2' if telescope see back.  
 (size)  
 (5) screen 4' 43'  
 (length) (depth to top)  
14 Johnson S.S. 7 slot with 2' 1/4 log pipe  
 (size) (material) test in well packer  
 (6) pump 3/4 7  
 (HP) (yield gpm)  
elec.  
 (type power)  
 (7) electric log no  
 (yes or no)

(organization running log)  
 (8) how well bottom plugged  
off bank ground

DRILLERS REMARKS:

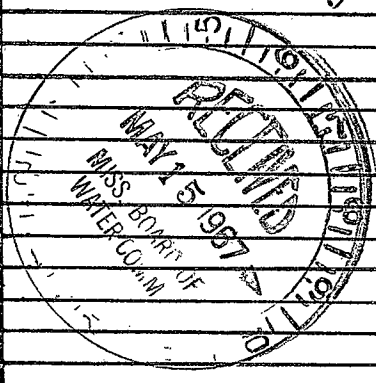

If well telescopes please sketch and show depths.

GROUND LEVEL

			X

SECTION 31

Please indicate well location X.

ADDITIONAL INFORMATION

If more than one screen,  
show locations of each on sketch.