

J 12

8-11-61

WATER WELL DRILLERS LOG

J

Date Aug 11, 1961, Driller: D. N. Porter Wm County Wayne

(Name)

(1) Owner of Land Dorsey Brigney
 (Name)
Waynesboro, Miss
 (Address)

Description & Color of Materials Sand, Clay, Red Clay, Shell, etc.	Thick- ness Feet	Depth Feet
<u>red clay</u>	<u>20</u>	<u>20</u>
<u>sand</u>	<u>17</u>	<u>37</u>

(2) Location: NE 1/4, SW 1/4, Sec. 7 T8R6
_____ miles _____ of Waynesboro
 (distance) (direction) (Nearest Town)

(3) Topography: flat
 (Hilly) (Flat) (Level)

(4) Purpose of Well: domestic
 (Domestic Irrigation
 Municipal, Industrial, Other)

Information upon completion of well:

(1) Diameter 2" inches.

(2) Total Depth 37' feet.

(3) Water Level 21' feet below top of ground.

(4) Cased to 32', Size 2"


(5) Screen: Size 1 1/4", Length 5'

(6) Were any formations sealed against pollution?
 _____ yes, _____ no.

If YES depth of formation _____

Why _____

Drillers Remarks: _____

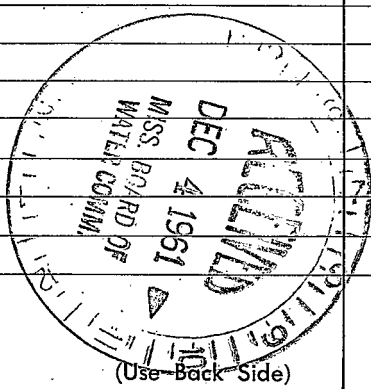

Well No.

