

J 13

J

8-29-61

WATER WELL DRILLERS LOG

Date: Aug 29, 1961, Driller: D. W. Portwood County: Wayne

(Name)

(1) Owner of Land: Red Hindman (Name)

Description & Color of Materials Sand, Clay, Red Clay, Shell, etc. Thickness Feet Depth Feet

At 2 Waynesboro (Address)

clay 25 25  
silt & chalk 35 60  
sand 9 69

(2) Location: SE 1/4, NE 1/4, Sec. 29, T. 9, R. 6

3 miles NE of Waynesboro (distance) (direction) (Nearest Town)

(3) Topography: hilly (Hilly) (Flat) (Level)

(4) Purpose of Well: domestic (Domestic Irrigation Municipal, Industrial, Other)

Information upon completion of well:

(1) Diameter 2 inches.

(2) Total Depth 69 feet.

(3) Water Level 55 feet below top of ground.

(4) Cased to 63, Size 2

(5) Screen: Size 1 1/4, Length 6


(6) Were any formations sealed against pollution?

yes, no.

If YES depth of formation:

Why:

Drillers Remarks:

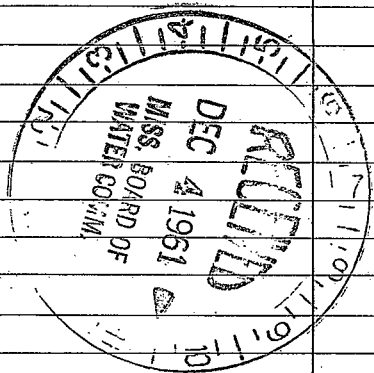

(Use Back Side)

Well No.

