

WAYNE MISSISSIPPI BOARD OF WATER COMMISSIONERS

J 16  
9-13-65

WATER WELL DRILLERS LOG

Date: Sept 13, 1965, Driller: Porter Drilling Co County: Wayne  
(Name)


(1) Owner of Land: Paley Beard  
(Name)  
Rt 2 Waynesboro, Missa  
(Address)  
(2) Location: NE 1/4, NE 1/4, Sec 18 T9R6  
6 miles N of Waynesboro  
(distance) (direction) (Nearest Town)  
(3) Topography: Hilly  
(Hilly) (Flat) (Level)  
(4) Purpose of Well: domestic  
(Domestic Irrigation  
Municipal, Industrial, Other)

Description & Color of Materials Sand, Clay, Red, Clay, Shell, etc.	Thick- ness Feet	Depth Feet
<u>red clay</u>	<u>8</u>	<u>8</u>
<u>soupy sand</u>	<u>12</u>	<u>20</u>
<u>soupy sand to chalk</u>	<u>12</u>	<u>32</u>
<u>med coarse sand</u>	<u>15</u>	<u>47</u>
<u>white chalk</u>	<u>1</u>	<u>48</u>
<u>med coarse sand</u>	<u>14</u>	<u>62</u>
<u>" " red sand</u>	<u>4</u>	<u>66</u>
<u>chalk</u>	<u>12</u>	<u>78</u>

Information upon completion of well:

(1) Diameter 2" inches.  
(2) Total Depth 67' feet.  
(3) Water Level 58' feet below top of ground.  
(4) Cased to 62', Size 2"  
(5) Screen: Size 1 1/4", Length 6'  
60 ga well shell furnished  
(6) Were any formations sealed against pollution?  
no yes, X no.

If YES depth of formation \_\_\_\_\_  
Why \_\_\_\_\_  
Drillers Remarks: \_\_\_\_\_

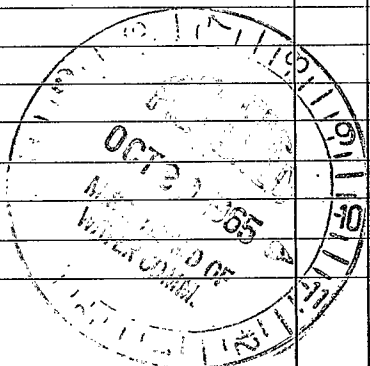

(Use Back Side)

Well No.

