

WAYNE MISSISSIPPI BOARD OF WATER COMMISSIONERS

J17

10-21-65

WATER WELL DRILLERS LOG

Date: Oct 21, 1965, Driller: Porter Drilling Co. Wayne County, N. C.
(Name)

(1) Owner of Land: <u>Mr Estell Dickerson</u> (Name)	Description & Color of Materials Sand, Clay, Red Clay, Shell, etc.	Thick- ness Feet	Depth Feet
<u>Rt 2 Waynesboro Miss.</u> (Address)	red clay	10	10
(2) Location: <u>NE 1/4, SE 1/4, Sec 22 T9 R6</u>	red sand	44	54
<u>6</u> miles <u>NE</u> , of <u>Waynesboro</u> (distance) (direction) (Nearest Town)	red chalk & some sand	34	88
(3) Topography: <u>Hilly</u> (Hilly) (Flat) (Level)	rock	1	89
(4) Purpose of Well: <u>domestic</u> (Domestic Irrigation Municipal, Industrial, Other)	blue chalk	5	94
	rock	1	95
	blue chalk	13	108
	rock	2	110
	blue chalk	8	118
	fine sand	3	121
	blue chalk	18	139
	honeycom rock	19	158
	white chalk & some rock	22	180


Information upon completion of well:

- (1) Diameter 2" inches.
- (2) Total Depth 180' feet.
- (3) Water Level 138' feet below top of ground.
- (4) Cased to 150', Size 2"
- (5) Screen: Size none, Length _____
- (6) Were any formations sealed against pollution?
_____ yes, _____ no.

If YES depth of formation _____

Why _____

Drillers Remarks: _____

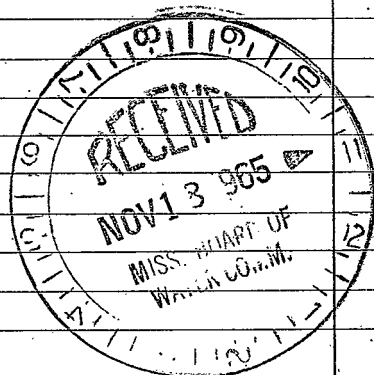

(Use Back Side)

Well No.

