

Wayne
T 18
9-66

MISSISSIPPI BOARD OF WATER COMMISSIONERS

WATER WELL DRILLERS LOG

Date: Sept, 1966, Driller: Peeples Drilling Co County Wayne
(Name)


(1) Owner of Land:	Description & Color of Materials Sand, Clay, Red Clay, Shell, etc.	Thick- ness Feet	Depth Feet
(Name) <u>Mauldin</u>	<u>Red hardy clay</u>	<u>35</u>	<u>35</u>
(Address) <u>Waynesboro</u>	<u>yellow sand</u>	<u>31</u>	<u>66</u>
(2) Location: <u>SW 1/4, SW 1/4, Sec. 23 T 9 R 6E</u> <u>8</u> miles <u>NE</u> of <u>Waba</u> (distance) (direction) (Nearest Town)	<u>Blue clay</u> <u>Yellow clay & sand</u> <u>strata</u>	<u>6</u>	<u>72</u> <u>28</u> <u>100</u>
(3) Topography: <u>Hilly</u> (Hilly) (Flat) (Level)	<u>Blue clay & limestone</u> <u>strata</u>		<u>47</u> <u>147</u>
(4) Purpose of Well: <u>Farm & livestock</u> (Domestic Irrigation Municipal, Industrial, Other)	<u>white limestone & rock</u>	<u>84</u>	<u>231</u>

Information upon completion of well:

- (1) Diameter 4 inches.
- (2) Total Depth 231 feet.
- (3) Water Level 130 feet below top of ground.
- (4) Cased to 120', Size 4"
- (5) Screen: Size NONE, Length _____
- (6) Were any formations sealed against pollution?
 yes, _____ no.

If YES depth of formation 66
Why Possible Contamination

Drillers Remarks:

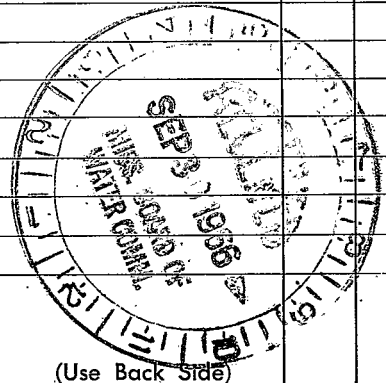

Well No. _____

(Use Back Side)

