

Wayne
T 20
12-66

MISSISSIPPI
BOARD OF WATER COMMISSIONERS
416 North State Street
Jackson, Mississippi 39201

WATER WELL DRILLERS LOG

Dec 27 1966 Porter Drilling & Log Wayne
date well completed firm name county well located

LANDOWNER:

Lloyd Everett
At 2 Waynesboro Miss
(mailing address)

description of formations encountered

	from	to
<u>rest clay</u>	0	20
<u>sand</u>	20	33
<u>Chalky sand</u>	33	46
<u>sand mixed with some chalk</u>	46	67

WELL LOCATION:

sec 33 T 9 N R 6 E
S W
4 miles NE of Waynesboro
(distance) (direction) (nearest town)


WELL PURPOSE:

home
(home, irrigation, municipal, industrial)

WELL COMPLETION DATA:


- (1) diameter (inches) 2"
- (2) total depth (feet) 65'
- (3) static water level (feet) 55' below top of ground.
- (4) casing steel 61'
(material) (depth)
2" if telescope see back.
(size)
- (5) screen 4' 61'
(length) (depth to top)
2" brass jacket
(size) (material)
- (6) pump 3/4 5
(HP) (yield gpm)
elec.
(type power)
- (7) electric log no
(yes or no)
(organization running log)
- (8) how well bottom plugged
flush gravel

DRILLERS REMARKS:

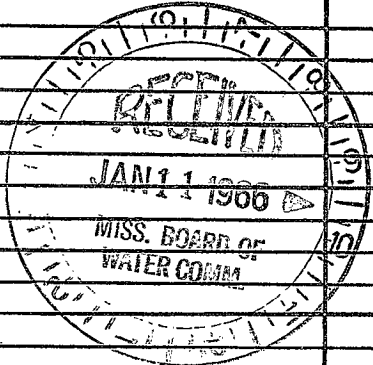

If well telescopes please sketch and show depths.

GROUND LEVEL

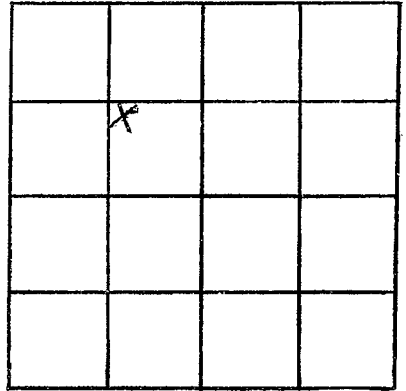

SECTION 33

Please indicate well location X.

ADDITIONAL INFORMATION

If more than one screen,
show locations of each on sketch.