

**MISSISSIPPI
BOARD OF WATER COMMISSIONERS**
416 North State Street
Jackson, Mississippi 39201

WATER WELL DRILLERS LOG

Wayne
J21
10-67

Oct 23 1967 Porter Drilling & Sup Wayne
date well completed firm name county well located

LANDOWNER: Mr Frank Holder

At 4 Waynesboro Miss
(mailing address)

WELL LOCATION:
sec. 18 T. 9 (N) S. R. 6 E. (W)
5 miles N of Waynesboro
(distance) (direction) (nearest town)

WELL PURPOSE: Home
(home, irrigation, municipal, industrial)

WELL COMPLETION DATA:


- (1) diameter (inches) 2"
- (2) total depth (feet) 72'
- (3) static water level (feet) 60' below
top of ground.
- (4) casing steel, 68 1/2'
(material) (depth)
2"
(size) If telescope see back.
- (5) screen 3 1/2', 68 1/2'
(length) (depth to top)
2", Schlert Johnson S.S.
(size) (material)
- (6) pump 1/2 3 1/2
(HP) (yield gpm)
elec
(type power)
- (7) electric log no
(yes or no)

(organization running log) _____

(8) how well bottom plugged flush point

DRILLERS REMARKS: _____

description of formations encountered	from	to
<u>rest clay</u>	<u>0</u>	<u>8</u>
<u>sand</u>	<u>8</u>	<u>39</u>
<u>Chalk</u>	<u>39</u>	<u>58</u>
<u>sand</u>	<u>58</u>	<u>69</u>
<u>sand & chalk</u>	<u>69</u>	<u>74</u>
<u>rest of chalk</u>		

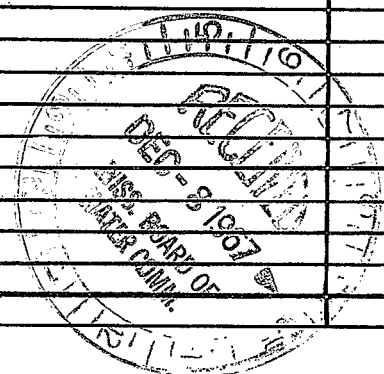

If well telescopes please sketch and show depths.

GROUND LEVEL

			X

SECTION 18

Please indicate well location X.

ADDITIONAL INFORMATION

If more than one screen, show locations of each on sketch.