

MISSISSIPPI
BOARD OF WATER COMMISSIONERS
416 North State Street
Jackson, Mississippi 39201

WATER WELL DRILLERS LOG

Wayne
T 22
11-67

Nov 7 1967 date well completed
Porter Drilling & Log firm name
Wayne county well located

LANDOWNER: Eugene Jordan

description of formations encountered

from to

212 Haynesboro (mailing address)

red clay
white chert & sand
sand
chert

0	10
10	22
22	53
53	55

WELL LOCATION:

sec. 23 T 9 N R 6 E
S W
4 miles NE of Haynesboro
(distance) (direction) (nearest town)

WELL PURPOSE: Home
(home, irrigation, municipal, industrial)


WELL COMPLETION DATA:

- (1) diameter (inches) 2'
- (2) total depth (feet) 53'
- (3) static water level (feet) 42' below top of ground.
- (4) casing steel, 47' (depth)
2" (size) if telescope see back.
- (5) screen 6' (length), 47' (depth to top)
1 1/4" (size), log brass jacket (material)
- (6) pump 1/2 (HP), 6 (yield gpm)
elec (type power)
- (7) electric log no (yes or no)

(organization running log)

(8) how well bottom plugged
flashed point

DRILLERS REMARKS:

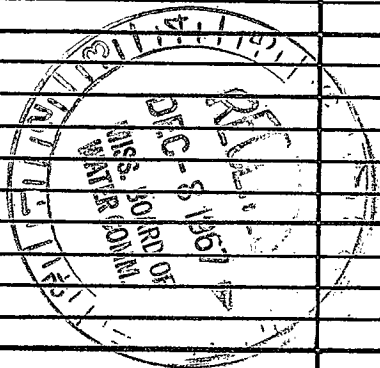

If well telescopes please
sketch and show depths.

GROUND LEVEL

X			

SECTION 33

Please indicate well location X.

ADDITIONAL INFORMATION

If more than one screen,
show locations of each on sketch.