

Wayne

830

9-68

MISSISSIPPI  
 BOARD OF WATER COMMISSIONERS  
 416 North State Street  
 Jackson, Mississippi 39201

CODED

WATER WELL DRILLERS LOG

Sept 7

1968

Porter Drilling Co

Wayne

date well completed

firm name

county well located

LANDOWNER:

James Lighter

description of formations encountered

from

to

Station H. Thunesboro  
(mailing address)

red clay	0	2
sand & gravel	2	22
white chalk	22	35
blue shale	35	43
blue sand shale	43	51
loam sand	51	54
slip on blue chalk		

WELL LOCATION:

sec 34 T 90 N R 6 E  
 S W  
 4 miles NE of Thunesboro  
 (distance) (direction) (nearest town)

WELL PURPOSE:

camp (home, irrigation, municipal, industrial)

WELL COMPLETION DATA:

- (1) diameter (inches) 2'
- (2) total depth (feet) 54'
- (3) static water level (feet) 23' below top of ground.
- (4) casing steel 51' (material), (depth)  
2' (size) if telescope see back.
- (5) screen 3' 51' (length), (depth to top)  
1/2" galv s.s. (material)
- (6) pump 3/4 7 (HP), (yield gpm)  
elec (type power)

12" 1" by pipe on screen the 1/2" with pack


CODED

(7) electric log (yes or no)

(organization running log)

(8) how well bottom-plugged

DRILLERS REMARKS:

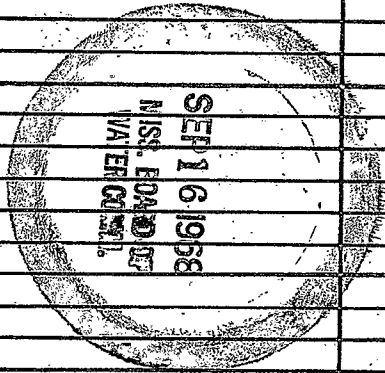

If well telescopes please sketch and show depths.

GROUND LEVEL

X			

SECTION 34

Please indicate well location X.

ADDITIONAL INFORMATION

If more than one screen, show locations of each on sketch.