

MISSISSIPPI  
BOARD OF WATER COMMISSIONERS  
416 North State Street  
Jackson, Mississippi 39201

CODED

WATER WELL DRILLERS LOG

Wayne  
531  
10-31-68

10/31 date well completed 1968 Cann Water Well Serv firm name Wayne county well located

LANDOWNER: ANDREW BEARD  
901 COURT ST.  
WAYNESBORO MISS  
(mailing address)  
WELL LOCATION:  
sect 17 T 9 N R 6 E  
5 miles NNE of WAYNESBORO  
(distance) (direction) (nearest town)


description of formations encountered	from	to
TOP SOIL	0	2
BROWN SANDY CLAY	2	12
PINK & GRAY CLAY	12	15
Med Red SAND	15	25
Med BROWN to Redish SD	25	30
BROWN to COARSE Redish SD	30	36
COARSE GRAYISH SD	36	42
Med GRAY to white SA	42	50
Light Layer R BROWN SD-Rock w/ COARSE SD	50	52
Yellow CLAY	52	59
Blue shale	59	63
Broken lime Rock	63	67
GRAY shale	67	75
GRAYISH Lime Rock	75	77
GRAY light spongy clay	77	83
GRAY shale	83	103
white lime Rock	103	128
W/SD.		

WELL PURPOSE:  
(home, irrigation, municipal, industrial)

WELL COMPLETION DATA:

- (1) diameter (inches) 2" x 4"
- (2) total depth (feet) 128'
- (3) static water level (feet) 103' <sup>(below)</sup> <sub>(above)</sub> top of ground.
- (4) casing Galv, 125'  
(material) (depth)  
\_\_\_\_ If telescope see back.  
(size)
- (5) screen 5', 125'  
(length) (depth to top)  
1 1/4", STAINLESS STEEL  
(size) (material)
- (6) pump 2 10  
(HP) (yield gpm)
- Elect  
(type power)
- (7) electric log No  
(yes or no)  
\_\_\_\_\_  
(organization running log)
- (8) how well bottom plugged well  
Paint


CODED

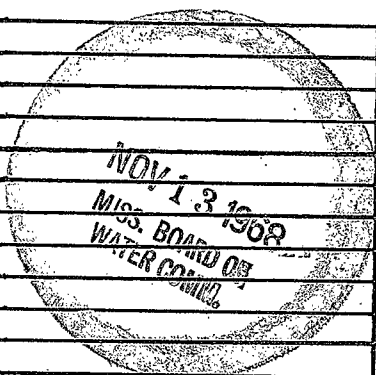

DRILLERS REMARKS: well paint  
set with packhead  
STILL IN lime Rock

If well telescopes please sketch and show depths.

GROUND LEVEL

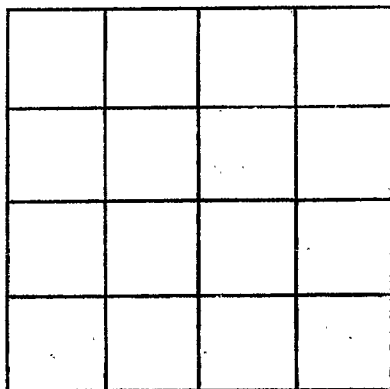

SECTION 17

Please indicate well location X.

ADDITIONAL INFORMATION

If more than one screen, show locations of each on sketch.