

Wayne
 J32
 10-26-68

MISSISSIPPI
 BOARD OF WATER COMMISSIONERS
 416 North State Street
 Jackson, Mississippi 39201

CODED

WATER WELL DRILLERS LOG

Oct 26 1968 date well completed
 P. B. P. Drilling & Log firm name
 Wayne county well located

LANDOWNER: Benford Gandy
Box 4 Waynesboro Miss
 (mailing address)

description of formations encountered	from	to
red clay	0	20
sand & shell	20	40
intercourse white sand	40	52
shale	52	58
red to mud course		
sand at bottom	58	75
stagnant water still in sand		

WELL LOCATION:
 sec 20 T 9 N R 6 E
4 miles NE of Waynesboro
 (distance) (direction) (nearest town)

WELL PURPOSE: home
 (home, irrigation, municipal, industrial)

- WELL COMPLETION DATA:
- (1) diameter (inches) 2"
 - (2) total depth (feet) 75'
 - (3) static water level (feet) 61 ^{below}/_{above} top of ground.
 - (4) casing steel, 69'
 (material) (depth)
5" if telescope see back.
 (size)
 - (5) screen 5', 70'
 (length) (depth to top)
1/2" galot s.s.
 (size) (material)
 - (6) pump 1 8
 (HP) (yield gpm)
elec.
 (type power)
 - (7) electric log no
 (yes or no)
- (organization running log)
- (8) how well bottom plugged flush point

CODED


NOV 7 1968

MISS. BD. OF
 WATER COMM.

DRILLERS REMARKS:

If well telescopes please sketch and show depths.

GROUND LEVEL

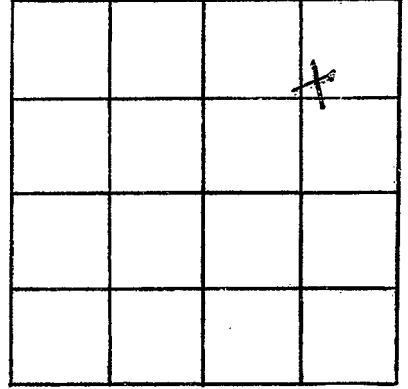

SECTION 20

Please indicate well location X.

ADDITIONAL INFORMATION

If more than one screen,
show locations of each on sketch.