

Wayne
 J 34
 9-20-68

MISSISSIPPI
 BOARD OF WATER COMMISSIONERS
 416 North State Street
 Jackson, Mississippi 39201

CODED

WATER WELL DRILLERS LOG

Sept. 20 1968 Agri Well Service Wayne
 date well completed firm name county well located
Silas Allen

LANDOWNER: Decell Dugas
Waynesboro Miss
P.O.
 (mailing address)


description of formations encountered	from	to
	Surface Sand	0
Clay	20	62
Sand	62	80

WELL LOCATION:
 sec. 32 T. 9 N. R. 6 E. S. W
3 1/2 miles N.E. of Waynesboro
 (distance) (direction) (nearest town)

WELL PURPOSE: Home
 (home, irrigation, municipal, industrial)

- WELL COMPLETION DATA:
- diameter (inches) 2 in
 - total depth (feet) 80 ft
 - static water level (feet) 50 ft below top of ground.
 - casing Galv. Iron 75
 (material) (depth)
2 in If telescope see back.
 (size)
 - screen 2 ft 75
 (length) (depth to top)
2 in Brass gauze
 (size) (material)
 - pump 1/3 3 1/2
 (HP) (yield gpm)
110 ScP
 (type power)
 - electric log No
 (yes or no)
 (organization running log)
 - how well bottom plugged B.W.V

CODED

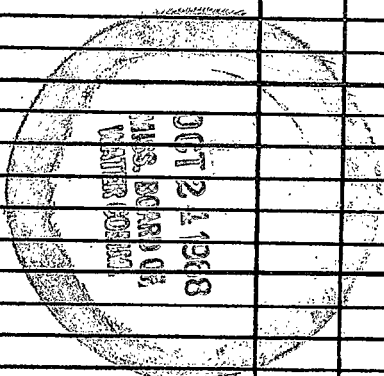

DRILLERS REMARKS:

If well telescopes please sketch and show depths.

GROUND LEVEL

	X		

SECTION 32

Please indicate well location X.

ADDITIONAL INFORMATION

If more than one screen,
show locations of each on sketch.