

Wayne  
 535  
 8-18-68

MISSISSIPPI  
 BOARD OF WATER COMMISSIONERS  
 416 North State Street  
 Jackson, Mississippi 39201

**CODED**

WATER WELL DRILLERS LOG

8/18 1968 *Devin Water Well Dr. Wayne*  
 date well completed firm name  
*Fields Ala. Pt. 1* county well located

LANDOWNER: *Ralph Blease*  
*Waynesboro Miss*

description of formations encountered	from	to
<i>Surface Sand</i>	<i>0</i>	<i>15</i>
<i>Clay</i>	<i>15</i>	<i>55</i>
<i>Sand</i>	<i>55</i>	<i>65</i>

(mailing address)

WELL LOCATION:


sec. *31* T. *9* N. R. *6* E. W. *9*  
*1 1/2* miles *NE* of *Waynesboro*  
 (distance) (direction) (nearest town)

WELL PURPOSE: *Home*  
 (home, irrigation, municipal, industrial)

WELL COMPLETION DATA:

- (1) diameter (inches) 2
- (2) total depth (feet) 65
- (3) static water level (feet) 18 below above top of ground.
- (4) casing *Galvanized 60*  
 (material) (depth)  
2 If telescope see back.  
 (size)
- (5) screen 5 60  
 (length) (depth to top)  
2 *Brass Gauge*  
 (size) (material)
- (6) pump 1 9 1/2  
 (HP) (yield gpm)  
110v. Single Phase  
 (type power)
- (7) electric log *No*  
 (yes or no)
- (organization running log)
- (8) how well bottom plugged *B.W.V*

**CODED**

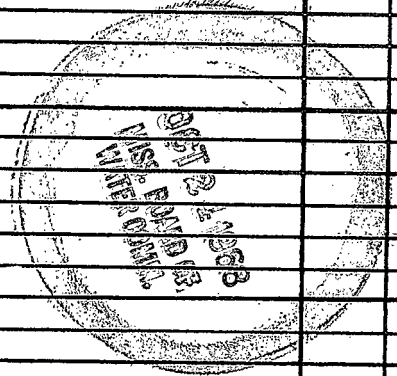

DRILLERS REMARKS:

If well telescopes please sketch and show depths.

GROUND LEVEL

X		A	

SECTION 31

Please indicate well location X.

ADDITIONAL INFORMATION

If more than one screen, show locations of each on sketch.