

WAYNE
 J 37
 4-19-68

Dozier
 MISSISSIPPI
 BOARD OF WATER COMMISSIONERS
 416 North State Street
 Jackson, Mississippi 39201
 WATER WELL DRILLERS LOG

CODE 1
 CODE 2
 CODE 3

4/19 1968 *Dozier Water Well Drilling* *Wayne*
 date well completed firm name county well located

LANDOWNER: *Pat Henneon*
Matherne & Meis
 (mailing address)


description of formations encountered	from	to
0	0	30
<i>Surface Sand</i>	0	30
<i>Blue Clay</i>	30	130
<i>Sand</i>	130	148

WELL LOCATION:
 sec. *12* T *9* N R *6* E ?
16 miles *N.E.* of *Waynesboro*
 (distance) (direction) (nearest town)

WELL PURPOSE: *Home*
 (home, irrigation, municipal, industrial)


- WELL COMPLETION DATA:
- diameter (inches) _____
 - total depth (feet) *148 ft*
 - static water level (feet) *70 ft* below top of ground
 - casing *Galv.* *143 ft*
 (material) (depth)
 - screen *5* *143*
 (length) (depth to top)
5 in *S.S.*
 (size) (material)
 - pump *1 HP* *5*
 (HP) (yield gpm)
110 S.P.
 (type power)
 - electric log *NS*
 (yes or no)
 (organization running log) _____
 - how well bottom plugged *B.M.D.*

DRILLERS REMARKS:

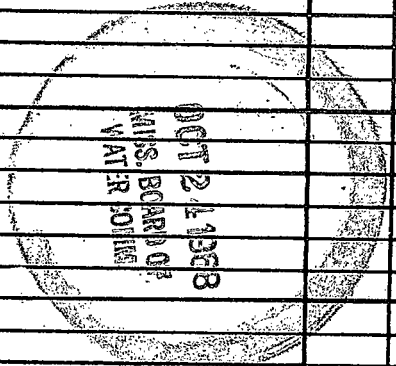

If well telescopes please sketch and show depths.

GROUND LEVEL

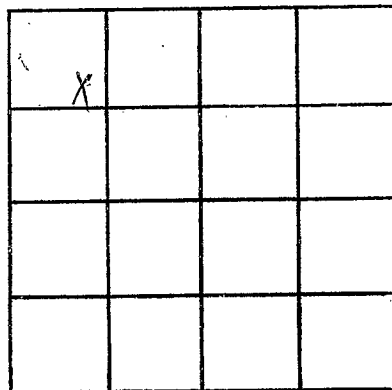

SECTION 12

Please indicate well location X.

ADDITIONAL INFORMATION

If more than one screen,
show locations of each on sketch.