

WAYNE
 8 38
 7-18-69

MISSISSIPPI
 BOARD OF WATER COMMISSIONERS
 416 North State Street
 Jackson, Mississippi 39201

CODED

CODED

WATER WELL DRILLERS LOG

July 18 1969 Porter Drilling & Log Wayne
 (date well completed) (firm name) (county well located)

LANDOWNER: <u>John Blakemore</u>	description of formations encountered	from	to
<u>214 Hammerhead Miss</u> (mailing address)	<u>red clay</u>	0	6
	<u>14 ft. red clay</u>	6	50
	<u>blue shale</u>	57	62
	<u>blue shale</u>	62	72
	<u>blue shale</u>	72	73
	<u>blue shale</u>	73	70
	<u>blue shale</u>	90	132

AUG 7 5 1969

MISS. Bd. OF WATER COMMISSIONERS

LANDOWNER: John Blakemore

description of formations encountered

from to

WELL LOCATION:

sec. 7 T. 90 N. R. 6 E. S. 1 W.
7 miles W of Hammerhead
 (distance) (direction) (nearest town)

WELL PURPOSE: drinking
 (home, irrigation, municipal, industrial)

WELL COMPLETION DATA:


- (1) diameter (inches) 2"
- (2) total depth (feet) 132
- (3) static water level (feet) 104 (below/above top of ground)
- (4) casing steel (material), 136' (depth)
2" (size) if telescope see back.
- (5) screen none (length), none (depth to top)
none (size), none (material)
- (6) pump 1 1/2 (HP), 8 1/2 (yield gpm)
elec. (type power)
- (7) electric log yes (yes or no)
none (organization running log)
- (8) how well bottom plugged open

DRILLERS REMARKS:

92' of casing

If well telescopes please sketch and show depths.

GROUND LEVEL

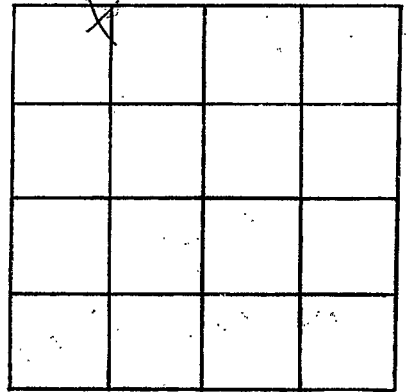

SECTION 9

Please indicate well location X.

ADDITIONAL INFORMATION

If more than one screen,
show locations of each on sketch.