

Wayne
 F 39
 7-69

MISSISSIPPI
 BOARD OF WATER COMMISSIONERS
 416 North State Street
 Jackson, Mississippi 39201

CODED


WATER WELL DRILLERS LOG

July 31 1969 *Probs Drilling Co* Wayne
 date well completed firm name county well located

LANDOWNER: <i>Albert Gooden</i>	description of formations encountered	from	to
<p>42 <i>Wayne</i> <i>Miss</i> (mailing address)</p>	<p><i>red clay</i> <i>red sand shale</i> <i>fine sand shale</i> <i>hard sand shale</i> <i>granite chert</i></p>	<p><i>0</i> <i>20</i> <i>42</i> <i>62</i></p>	<p><i>20</i> <i>42</i> <i>62</i> <i>66</i></p>
<p>WELL LOCATION: sec <i>11</i> T <i>9</i> N R <i>6</i> E <i>1</i> miles <i>NE</i> of <i>Wayne</i> (distance) (direction) (nearest town)</p>			
<p>WELL PURPOSE: (home, irrigation, municipal, industrial)</p>	<p><i>drinking water</i></p>		
<p>WELL COMPLETION DATA:</p>			
<p>(1) diameter (inches) <i>2"</i></p>	<p><i>cracks 57' 1/2 deep</i></p>		
<p>(2) total depth (feet) <i>66'</i></p>	<p><i>Pump</i></p>		
<p>(3) static water level (feet) <i>50</i> below top of ground.</p>			
<p>(4) casing <i>steel</i> <i>60'</i> (material) (depth) <i>2"</i> (size) if telescope see back.</p>			
<p>(5) screen <i>6'</i> <i>60'</i> (length) (depth to top) <i>1/2"</i> <i>bronze</i> (size) (material)</p>			
<p>(6) pump <i>3/4</i> <i>8</i> (HP) (yield gpm) <i>elec</i> (type power)</p>			
<p>(7) electric log <i>yes</i> (yes or no) (organization running log)</p>			
<p>(8) how well bottom plugged <i>not plugged</i></p>			
<p>DRILLERS REMARKS:</p>	<p><i>See log for details</i></p>		

If well telescopes please
sketch and show depths.

GROUND LEVEL

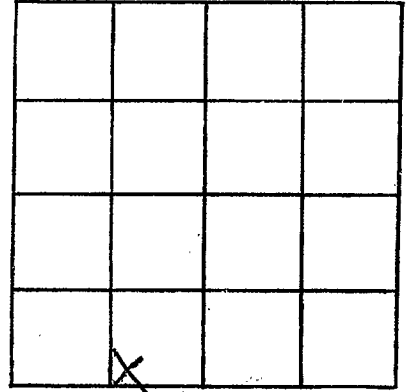

SECTION 31

Please indicate well location X.

ADDITIONAL INFORMATION

If more than one screen,
show locations of each on sketch.